

Cowley


KANSAS

SECTION 6 TOWNSHIP 32S RANGE 8E

WELL NO. #2 Jarvis "E"

COMPANY McNeish & Gralapp

NORTH SW/C Lot 15

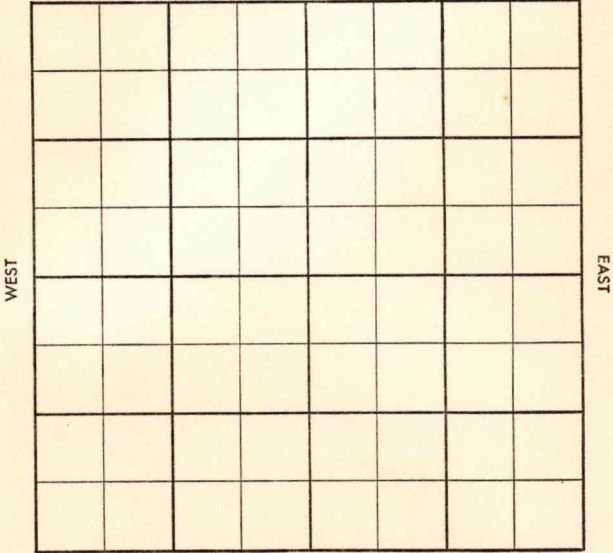

SOUTH

30

County Cowley Elev. 1295KB
 Sec. 6 Twp. 32 Rge. 8E
 Company McNeish & Gralapp
 Farm Name Jarvis "E" No. 2

TOPS	DEPTH	LOG	DATUM
Anh.			
Tp.			
H.			
Tr.			
Dg.			
B.L.			
L.			
K.C.			
B.K.C.			
Ce.			
C.			
M.			
M.			
K.			
Mz.			
Mq.			
V.			
S.			
S.			
A.			
R.			
Pf.			
G.			
T.D.			

Loc. in Sec. SW/C Lot 15
 Geol. McNeish
 Contr. Watson tools
 Pool Windsor SW

FIRST REPORT
JAN 22 '50

Date Comm. Skelly - FO

Location

Co.
Lse.
No.
Sec.
T.
R.

Top ~~_____~~ Foot ~~_____~~
 Co. ~~_____~~ Feet ~~_____~~

S-513-B

County Cowley Elev. 1295KB
 Sec. 6 Twp. 32 Rge. 8E
 Company McNeish & Gralapp
 Farm Name Jarvis "E" No. 2

TOPS	DEPTH	LOG	DATUM
Anh.			
Tp. <u>1072h</u>	<u>1448</u>		
H. <u>S 21</u>	<u>1637</u>		
Tr. <u>Hogshots</u>	<u>1963</u>		
Dg. <u>Log</u>	<u>1905</u>		
B.L.			
L.			
K.C.			
B.K.C.			
Ce.			
C.			
M.			
M.			
K.			
Mz.			
Mq.			
V.			
S.			
S.			
A.			
R.			
Pf.			
G.			
T.D.	<u>1917</u>		

Loc. in Sec. SW/C Lot 15

Geol. McNeish

Contr. Watson tools

Pool Windsor SW

COMPLETE

APR 16 '58

Date Comm. 1-27-58 Skelly - FO
 Location JAN 29 '58 8" 140 Ø 770 FEB 5 '58
cid 1907-17 5 1/2 1905 woc
FEB 12 '58 CD 1917TD FV 400' fld
frac 50h Ld FEB 19 '58 FEB 26 '58 MAR 5 '58
pop F10 30BOPH + trw
Ø 25BOPH + ~~trw~~ NW
trw
 MAR 12 '58 MAR 19 '58 MAR 26 '58 APR 2 '58 APR 9 '58
 APR 16 '58