Cowley


KANSAS

SECTION 7 TOWNSHIP 32S RANGE 8E

WELL NO. #1 Jarvis "B"

COMPANY Skelly Oil Co.

NORTH SW/C Lot 12

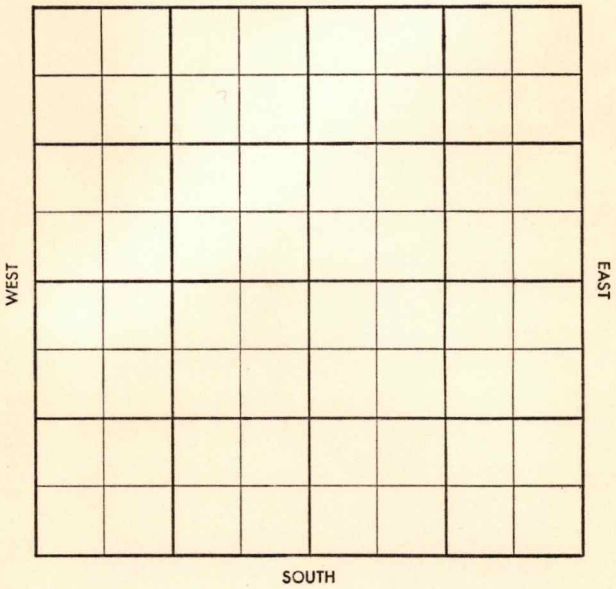

FORM 504-3 SUNRAY

Twp. No Pool No

Co. X Facet

S-513-B

Co.

County Cowley Elev.

Sec. 7 Twp. 32 Rge. 8E

Company Skelly Oil Co.

Farm Name Jarvis "B" No. 1

TOPS	DEPTH	LOG	DATUM
Anh.			
Tp.			
H.			
Tr.			
Dg.			
B.L.			
L.			
K.C.			
B.K.C.			
Ce.			
C.			
M.			
M.			
K.			
Mz.			
Mq.			
V.			
S.			
S.			
A.			
R.			
Pf.			
G.			
T.D.			

Loc. in Sec. SW/C Lot 12

Geol.

Contr.

Lse.

Pool Windsor SW

FIRST REPORT MAR 19


No.

Date Comm. WORT

Sec.

T.

R.

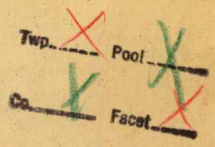

S-513-B

County Cowley Elev. 1225GF

Sec. 7 Twp. 32 Rge. 8E

Company Skelly Oil Co.

Farm Name Jarvis "B" No. 1

TOPS	DEPTH	LOG	DATUM
Anh Lay A°	1832		
Tp.			
H.			
Tr.			
Dg.			
B.L.			
L.			
K.C.			
B.K.C.			
Ce.			
C.			
M.			
M.			
K.			
Mz.			
Mq.			
V.			
S.			
S.			
A.			
R.			
Pf.			
G.			
T.D.	1904		

Loc. in Sec. SW/C Lot 12

Geol.

Contr.

Pool Windsor SW

COMPLETE

APR 23 '58

Date Comm. 4-3-58 8"150

WORT MAR 26 '58 APR 2 '58 APR 9 '58 DST 1832-42

op 60" G/45" 3'M BHP 645

DST 1859-84 op 60" 15' filtrate

w bmco 120' HO to gcm to SW

BH 631 log 5" 1904 4/125

APR 15 '58 co 1884 APR 23 '58 40/1865-75

B 11go + 11gw ph 7 hrs frac Flo Ld

& to Flo 68 BO NW 90"

SI CP 400# SITP 275

25 BO Pd NW