

STATE CORPORATION COMMISSION OF KANSAS
OIL & GAS CONSERVATION DIVISIONWELL COMPLETION OR RECOMPLETION FORM
ACO-1 WELL HISTORY

DESCRIPTION OF WELL AND LEASE

Operator: license # 5363
 name BEREXCO INC.
 address 970 Fourth Financial Center
 City/State/Zip Wichita, KS 67202

Operator Contact Person Evan C. Mayhew
 Phone 1-316-265-3311

Contractor: license # 5142
 name Sterling

Wellsite Geologist Sam Houston
 Phone 1-316-262-1163

PURCHASER Central Crude Corporation

Designate Type of Completion

☒ New Well ☐ Re-Entry ☐ Workover

☒ Oil ☐ SWD ☐ Temp Abd
☐ Gas ☐ Inj ☐ Delayed Comp.
☐ Dry ☐ Other (Core, Water Supply etc.)

If OWWO: old well info as follows:

Operator
 Well Name
 Comp. Date Old Total Depth

WELL HISTORY

Drilling Method: ☒ Mud Rotary ☐ Air Rotary ☐ Cable

12/10/84 12/18/84 03/06/85
 Spud Date Date Reached TD Completion Date

4314 4301
 Total Depth PBDT

Amount of Surface Pipe Set and Cemented at 349 feet

Multiple Stage Cementing Collar Used? ☒ Yes ☐ No

If Yes, Show Depth Set 1994 feet

Alternate 2 completion, cement circulated
 from 1994 feet depth to surface w/ 550 SX cmt

API NO. 15 - 063-20,851

County Gove

SW SW NW Sec. 29 Twp. 15S Rge. 29W X West
 (location)

2970 Ft North from Southeast Corner of Section

4950 Ft West from Southeast Corner of Section

(Note: locate well in section plat below)

Lease Name James Marion


Well# 1

Field Name JASPER

Producing Formation Kansas City

Elevation: Ground 2595 KB 2604

Section Plat

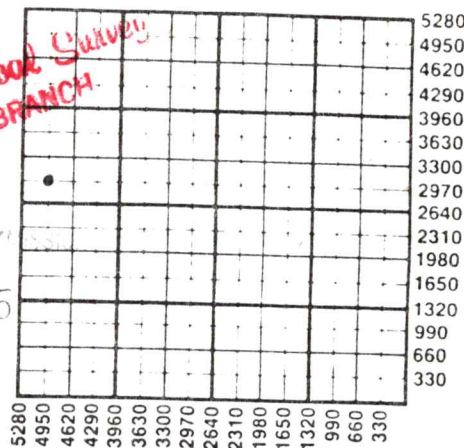

WATER SUPPLY INFORMATION

Source of Water:

Division of Water Resources Permit #

☐ Groundwater. Ft North From Southeast Corner and
 (Well) Ft West From Southeast Corner of
 Sec Twp Rge ☐ East ☐ West

☐ Surface Water. Ft North From Southeast Corner and
 (Stream, Pond etc.) Ft West From Southeast Corner
 Sec Twp Rge ☐ East ☐ West

☒ Other (explain) York Brothers
 (purchased from city, R.W.D.#)

Disposition of Produced Water: ☒ Disposal
 Docket # D-23,403 (Larry Vernon #2) ☐ Repressuring

INSTRUCTIONS: This form shall be completed in duplicate and filed with the Kansas Corporation Commission, 200 Colorado Derby Building, Wichita, Kansas 67202, within 90 days after completion or recompletion of any well. Rules 82-3-130 and 82-3-107 apply.

Information on side two of this form will be held confidential for a period of 12 months if requested in writing and submitted with the form. See rule 82-3-107 for confidentiality in excess of 12 months.

One copy of all wireline logs and drillers time log shall be attached with this form. Submit CP-4 form with all plugged wells. Submit CP-111 form with