

KARONS

Ellsworth

Section 24 Township 16 Range 10W

Well No. 8 Phillips

Company Herndon Drlg.

Stoltenberg NORTH

WEST

EAST

SOUTH

13

0 -

KANSAS

Ellsworth



Sec. 34 Twp. 16 R. 10W

Well No. #8 Phillips Farm

Herdon Drlg. Company

Stoltenberg Pool


Ft. from N. Line

990' Ft. from S. Line

Ft. from E. Line

330' Ft. from W. Line

NW SW SW

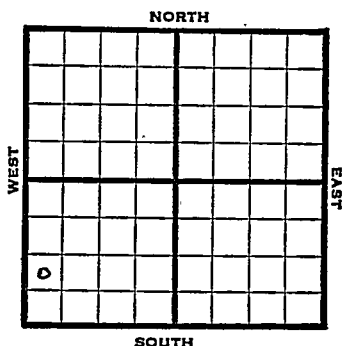

1948

Elev. 1818' REPORT

3/3

8" @ 345'
Arb. 3257'
TD 3259'
5" @ 3259'
RUST

3/10

"

3/17

"

3/24

"

3/31

TD 3266 $\frac{1}{2}$ '
500 Acid

4/7

TD 3283'
Swb. 30 bbls. oil PH 7 hrs.

4/14

Arb. 3257'
5" @ 3259'
Pump 455 Pot
42.0 Gr.
TD 3283'
Comp.

COMPLETED

Map No. _____ Sec. 34 Twp. 16 R. 10W

Well No. 8 Phillips

Herndon Drlg. Company

FIRST REPORT

Contractor

NW SW SW

SECTION PLAT

_____ Ft. from N. Line

990 Ft. from S. Line

_____ Ft. from E. Line

330 Ft. from W. Line

o			

Ellsworth County

Location _____

Rig up _____

Drilling and Remarks:

8" @ 345

Arb. 3257

TD 3259

5" @ 3259 RUST

RECORD

Cased _____ in., _____ ft.

Sand _____

Gas _____

Oil _____

Total Depth _____

PRODUCTION

1st 24 hrs. Nat. _____

1st 24 hrs. after shot _____

Gas _____ Cu. Ft.

Dry Hole _____

Abandoned _____

Date

MAR 3 1948

19

S. J. LEWIS Scout

Form 26—200 Bks.—1-48—Palace
KansasMap No. 55 Sec. 34 Twp. 16 R. 10WWell No. 8 PhillipsHerndon Drlg. Company

COMPLETE

Contractor

NW SW SW

E11818
SECTION PLAT

0			

 Ft. from N. Line990 Ft. from S. Line Ft. from E. Line330 Ft. from W. LineEllsworth CountyLocation Rig up

Drilling and Remarks:

Car 432575 " 43259Pump 4508842° SW

RECORD

Cased in., ft.Sand Gas Oil ✓Total Depth 3283

PRODUCTION

1st 24 hrs. Nat. 1st 24 hrs. after shot Gas Cu. Ft.Dry Hole Abandoned

Date

APR 14 1948

19

S. J. LEWIS

Scout