
FORM 51 10M 8-47

KANSAS Ellsworth

Section 34 Township 16 Range 10W

Well No. #9 Phillips

Company Herndon Drlg.
Stoltenberg

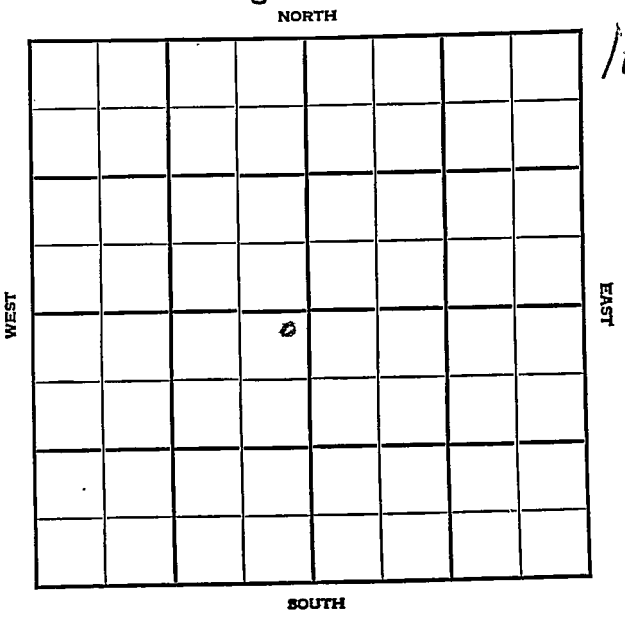

11

FORM 252-A
5M 4-48 PETROL

KANSAS Ellsworth ✓

Sec. 34 Twp. 16 R. 10W

Well No. #9 Phillips Farm

Herndon Drlg. Company

Stoltenberg


330' Ft. from N. Line

Ft. from S. Line

330' Ft. from E. Line

Ft. from W. Line

NE SW

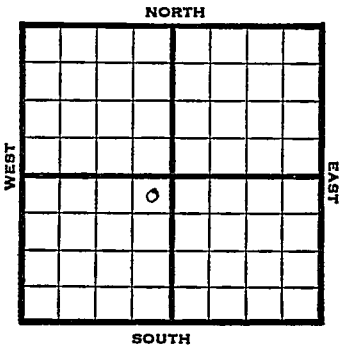

1948	Eli 1816' REPORT
6/23	Arb. 3251' 6" @ 3258' TD 3259'
6/29	Arbuckle 3254 corrected 6" @ 3256' TD 3269 Swb 40 bbls oil PH
7/14	TD 3269' Arb. 3254' 6"@ 3256' Pump 25 Oil Pot 42° Gr. Comp. **COMPLETED**

Form 26—200 Bks.—1-48—Palace

Stoltenberg

Kansas

Map No. _____ Sec. 34 Twp. 16 R. 10W

Well No. 9 Phillips

Herndon Drlg. Company

FIRST REPORT

Contractor

NE SW


330 Ft. from N. Line

_____ Ft. from S. Line

330 Ft. from E. Line

_____ Ft. from W. Line

SECTION PLAT

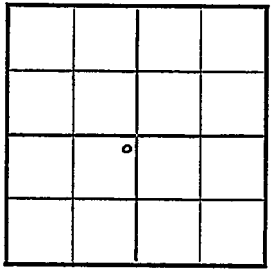

Ellsworth County

Location _____

Rig up _____

Drilling and Remarks:

Arb. 3251
6" @ 3258
TD 3259

RECORD

Cased _____ in., _____ ft.

Sand _____

Gas _____

Oil _____

Total Depth _____

PRODUCTION

1st 24 hrs. Nat. _____

1st 24 hrs. after shot _____

Gas _____ Cu. Ft.

Dry Hole _____

Abandoned _____

Date

JUN 23 1948 19

S. J. LEWIS Scout

Form 26—200 Bks.—1-48—Palace

Kansas

Stoltenberg Pool

Map No. 55 Sec. 34 Twp. 16 R. 10W

Well No. 9 Phillips


Herndon Drlg. Company

COMPLETE Contractor

NE SW

E.1876

SECTION PLAT

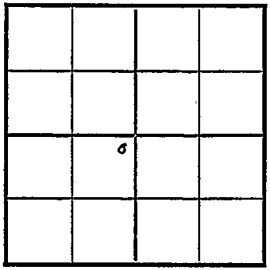

330 Ft. from N. Line

Ft. from S. Line

330 Ft. from E. Line

Ft. from W. Line

Ellsworth County

Location

Rig up

Drilling and Remarks:

Cem 3254

6" @ 3256.

Pump 25 oil B+S

422 Gas

RECORD

Cased in., ft.

Sand

Gas

Oil

Total Depth 3269

PRODUCTION

1st 24 hrs. Nat.

1st 24 hrs. after shot

Gas Cu. Ft.

Dry Hole

Abandoned

Date

JUL 14 1948 19

S. J. LEWIS Scout