

KANSAS

Form 51—5M—7-40—Palace

Ellsworth

Section 35 Township 16 Range 10-W

Well No. #2 Ehler

Company Aylward Production

NORTH Stoltenberg Pool

WEST

EAST

SOUTH

14

0

KANSAS


Ellsworth

Sec. 35 Twp. 16 R. 10-WWell No. #2 Ehler FarmAylward Production Company

(Stoltenberg)

 Ft. from N. Line1292 Ft. from S. Line440 Ft. from E. Line Ft. from W. Line

Elev. 1830

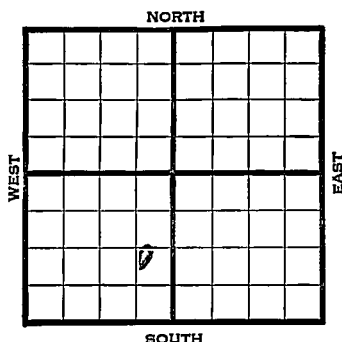

1940

REPORT

11/6

Rotary.

11/14

10" @ 170' Anhy 515'

Dr1g. 2325'

11/21

Arb. 3279-80' T.D. S.O.

5" - 3280' RUST.

11/27

T.D. 3293' 3100' oil.

1000 acid.

12/4

Arb. 3279'

5" - 3280'

T.D. 3293'

1000 acid.

Depthograph potential 5869 bbls.

Maximum 3000 bbls.

44.9 Gravity


COMPLETED

Map No. 55 Sec. 35 Twp. 16 R. 10WWell No. 2 EhlerAylward Production CompanyContractor**FIRST REPORT**

C E L SW

 Ft. from N. Line1292 Ft. from S. Line440 Ft. from E. Line Ft. from W. Line

STOLTENBERG POOL

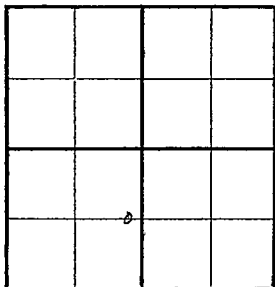SECTION PLATLocation Rig up Drilling and Remarks:
Rotary**RECORD**Cased in., ft.Sand Gas Oil Total Depth **PRODUCTION**1st 24 hrs. Nat. 1st 24 hrs. after shot Gas Cu. Ft.Dry Hole Abandoned

Date

NOV 6 1940 19 S. J. LEWIS Scout

Map No. 55 Sec. 35 Twp. 16 R. 10WWell No. 2 EhlerAylward Production Company

Contractor

COMPLETED

C E L SW

 Ft. from N. Line1292 Ft. from S. Line440 Ft. from E. Line Ft. from W. Line

STOLTENBERG POOL

SECTION PLAT

Location Rig up

Drilling and Remarks:

Cr 83279
5" C 3280
1000 acw/c
Depth 3293
Max 3000
44.9 gr.

RECORDCased in., ft.Sand Gas Oil Total Depth 3293**PRODUCTION**1st 24 hrs. Nat. 1st 24 hrs. after shot Gas Cu. Ft.Dry Hole Abandoned

Date

DEC 4 1940

19

S. J. LEWIS Scout