

KANSAS


Ellsworth

FORM 51 5M BRIX

Section 34 Township 16 Range 10W

Well No. #4, Schroeder "C"

Company Cities Service Oil

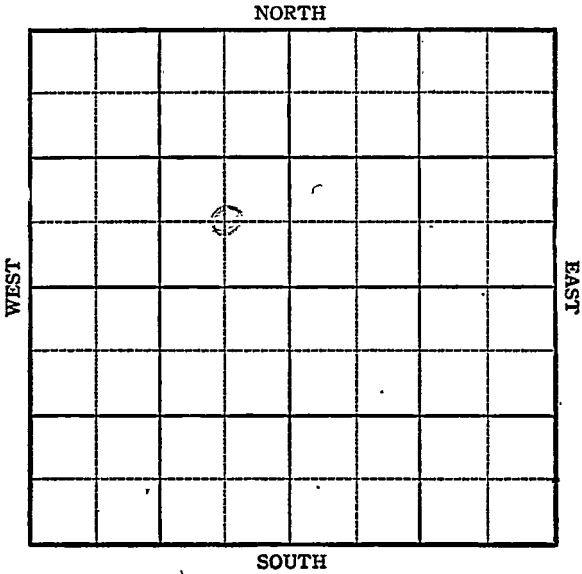

KANSAS

Sec. 34 Twp. 16 R. 10W

Well No. 4 Schroeder "C" Farm

Cities Service Oil Company

Stoltenberg


NORTH

_____ Ft. from N. Line

660 Ft. from S. Line

660 Ft. from E. Line

_____ Ft. from W. Line

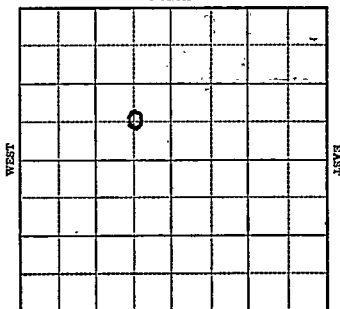

Elev. 1822

1944

R E P O R T

7/5	Loc.
7-12	8" at 312' - Drilling 1695'
7-19	Arb. 3272' TD 3277& 5" at 3278'
7-26	RUST
8-2	"
8-9	Arbuckle 3267 corrected. 5" @ 3268' Total Depth 3284 2250' oil in 18 hours. 1000 acid
8-16	Pump 40 oil in 8 hrs.
8-23	" "
8-30	" "
9-13	" "
9/20	Arb. 3267 5" @ 3268' 1000 acid Pump 140 Pot. TD 3284' Grav. 42.1

COMPLETED

KANSAS

Pool Name StoltenbergMap No. 55 Sec. 34 Twp. 16 R. 10WWell No. 4 Schroeder "C"Cities Service Oil Company

FIRST REPORT

Contractor

C SE NW

SECTION PLAT

_____ Ft. from N. Line

660 Ft. from S. Line660 Ft. from E. Line

_____ Ft. from W. Line

offset

Ellsworth County

Location X

Rig up _____

Drilling and Remarks:

RECORD

Cased _____ in., _____ ft.

Sand _____

Gas _____

Oil _____

Total Depth _____

PRODUCTION

1st 24 hrs. Nat. _____

1st 24 hrs. after shot _____

Gas _____ Cu. Ft.

Dry Hole _____

Abandoned _____

Date

III 5 1944 19S. J. LEWIS

Scout

Pool Name Stoltenberg Pool

KANSAS

Map No. 15 Sec. 34 Twp. 16 R. 10WWell No. 4 Schroeder "C"Cities Service Oil Company**COMPLETED**

Contractor

C SE NW

SECTION PLAT

 Ft. from N. Line660 Ft. from S. Line660 Ft. from E. Line Ft. from W. Line

	D		

Ellsworth CountyLocation Rig up

Drilling and Remarks:

Cell 832675-1032681000 acidPump 140 Pst42 1/2 G.

RECORD

Cased in., ft.Sand Gas Oil Total Depth 3284

PRODUCTION

1st 24 hrs. Nat. 1st 24 hrs. after shot Gas Cu. Ft.Dry Hole Abandoned

Date

SEP 20 1944 19S. J. LEWIS Scout