


**KANSAS** Butler

FORM 51 5M 4-41 PETROL

Section 21 Township 25 Range 5-E

Well No. #120 Chesney Twin 87

Company Cities Service Oil

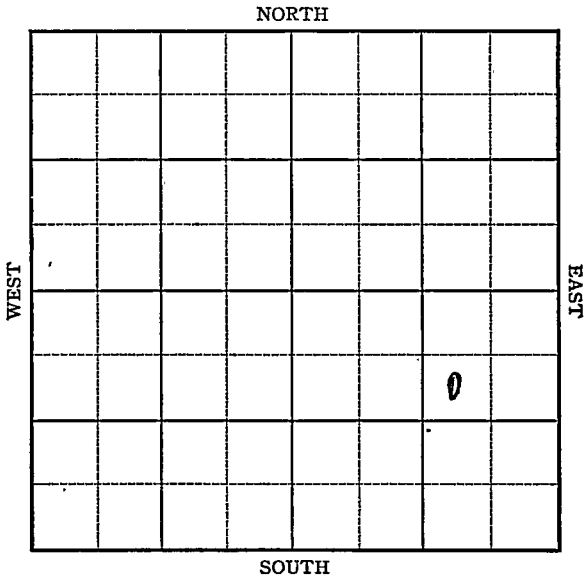



Map No. K-14 Sec. 21 Twp. 25 R. 5EWell No. 120 Chesney Twin 87Cities Service Oil CompanyFIRST REPORT Contractor

SW NE SE

990 Ft. from N. Line

Ft. from S. Line

990 Ft. from E. Line

Ft. from W. Line

## SECTION PLAT

			o

## MISCELLANEOUS

Location \_\_\_\_\_

Rig up \_\_\_\_\_

Drilling and Remarks:

Rotary

## RECORD

Cased \_\_\_\_\_ in., \_\_\_\_\_ ft.

Sand \_\_\_\_\_

Gas \_\_\_\_\_

Oil \_\_\_\_\_

Total Depth \_\_\_\_\_

## PRODUCTION

1st 24 hrs. Nat. \_\_\_\_\_

1st 24 hrs. after shot \_\_\_\_\_

Gas \_\_\_\_\_ Cu. Ft.

Dry Hole: \_\_\_\_\_

Abandoned \_\_\_\_\_

Date

OCT 22 1941 19

S. J. LEWIS Scout

Map No. K-14 Sec. 21 Twp. 25 R. 5EWell No. 120 Chesney twin 87Cities Service Oil Company**COMPLETED**

Contractor

SW NE SE

SECTION PLAT

990 Ft. from N. Line

\_\_\_\_\_ Ft. from S. Line

990 Ft. from E. Line

\_\_\_\_\_ Ft. from W. Line


MISCELLANEOUS

Location \_\_\_\_\_

Rig up \_\_\_\_\_

Drilling and Remarks:

KC 19236" @ 2171409 to 2177-2202Pump 10 oil36° SW

RECORD

Cased \_\_\_\_\_ in., \_\_\_\_\_ ft.

Sand \_\_\_\_\_

Gas \_\_\_\_\_

Oil \_\_\_\_\_

Total Depth 2206

PRODUCTION

1st 24 hrs. Nat. \_\_\_\_\_

1st 24 hrs. after shot \_\_\_\_\_

Gas \_\_\_\_\_ Cu. Ft.

Dry Hole \_\_\_\_\_

Abandoned \_\_\_\_\_

Date

NOV 25 1941

19

S. J. LEWIS

Scout