

# KANSAS


FORM 51 5M 10-41 PETROL

Butler

Section 21 Township 25 Range 5-E

Well No. 122 Cheeney

Company Cities Service Oil

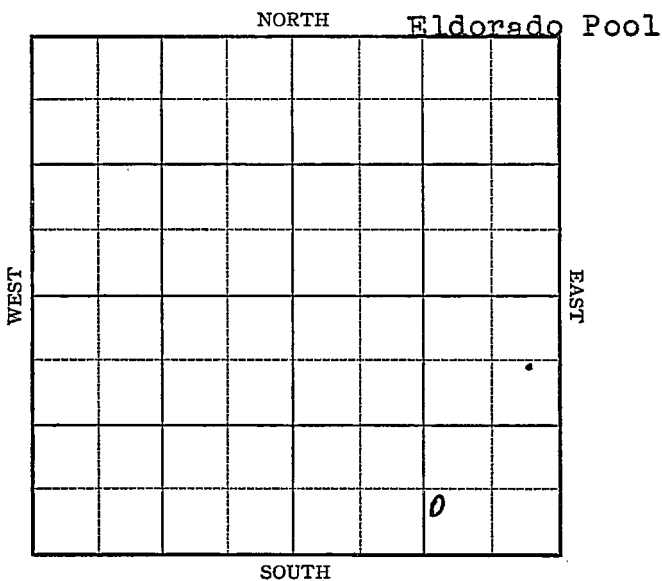

Sec. 21 Twp. 25 R. 5-E

Well No. #122 Cheeney Farm

Cities Service Oil

Company


(Eldorado)

\_\_\_\_\_ Ft. from N. Line

401 Ft. from S. Line

1061 Ft. from E. Line

\_\_\_\_\_ Ft. from W. Line

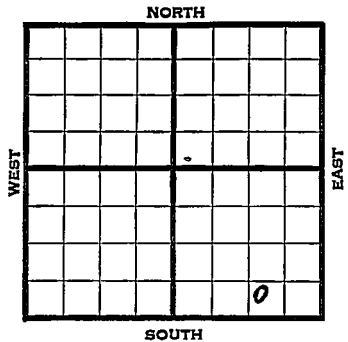

1941	REPORT
12/23	Location
12/31	"
1942	
1/8	"
1/15	"
1/22	"
1/29	"
2/5	"
2/12	"
2/19	"
2/26	"
3/5	"
3/12	Lans. 1631' Drlg. 1884'
3/19	K.C. 1926' 6" - 2160' T.D. 2207' 450' oil 32 hours.
3/26	" " "
4/2	" " "
4/8	" " "
	<b>OVER</b>

1942

4/15

K.C. 1926'

6" - 2106'

T.D. 2207'

Potential 20 bbls., pump.

36. Gravity

**COMPLETED**

Map No. 14 Sec. 21 Twp. 25 R. 5EWell No. 122 CheeneyCities Service Oil CompanyFIRST REPORT Contractor

SW SE SE

       Ft. from N. Line401 Ft. from S. Line1061 Ft. from E. Line       Ft. from W. Line

ELDORADO POOL

## SECTION PLAT


Location XXRig up       

Drilling and Remarks:

## RECORD

Cased        in.,        ft.Sand       Gas       Oil       Total Depth       

## PRODUCTION

1st 24 hrs. Nat.       1st 24 hrs. after shot       Gas        Cu. Ft.Dry Hole       Abandoned       

Date

DEC 23 1941

19

S. J. LEWIS Scout

Map No. 14 Sec. 21 Twp. 25 R. 5EWell No. 122 ChesneyCities Service Oil Company**COMPLETED** Contractor

SW SE SE

SECTION PLAT

\_\_\_\_\_ Ft. from N. Line

401 Ft. from S. Line1061 Ft. from E. Line

\_\_\_\_\_ Ft. from W. Line

			o

ELDORADO POOL

Location \_\_\_\_\_

Rig up \_\_\_\_\_

Drilling and Remarks:

*KC 1926**6" @ 2106**Pump 20 P.D.**36-4*

## RECORD

Cased \_\_\_\_\_ in., \_\_\_\_\_ ft.

Sand \_\_\_\_\_

Gas \_\_\_\_\_

Oil \_\_\_\_\_

Total Depth 2207

## PRODUCTION

1st 24 hrs. Nat. \_\_\_\_\_

1st 24 hrs. after shot \_\_\_\_\_

Gas \_\_\_\_\_ Cu. Ft.

Dry Hole \_\_\_\_\_

Abandoned \_\_\_\_\_

Date

APR 15 1942 19

S. J. LEWIS Scout