


Butler

FORM 51 5M 1-42 PETROL **KANSAS**

Section 21 Township 25 Range 5E

Well No. 123 Chesney

Company Cities Service Oil

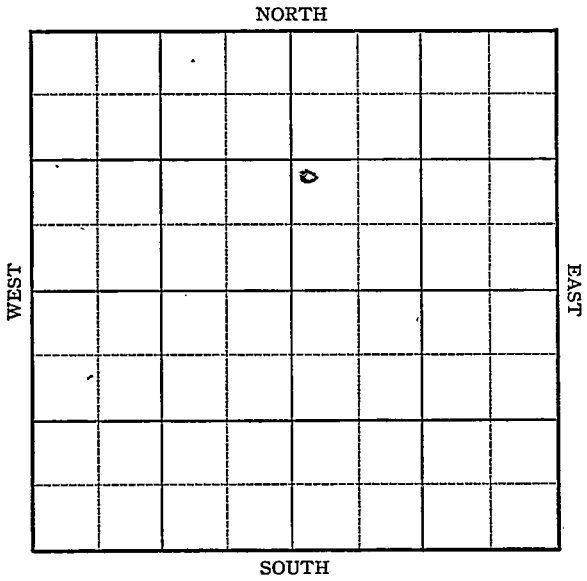

Sec. 21 Twp. 25 R. 5-E

Well No. #123 Chesney Farm

Cities Service Oil Company


Miscellaneous

_____ Ft. from N. Line

990 Ft. from S. Line

_____ Ft. from E. Line

330 Ft. from W. Line

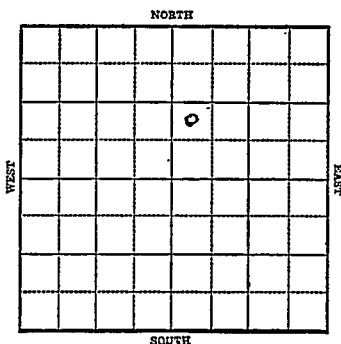

1942

R E P O R T

10/21 Location

10/28 Drlg 1047

11/4 Lans 1623

Kc 1910

Drlg. 2009

11/11 Base Lime 1761

Narmation 2166

6" @ 2166'

TD 2194' 800' Oil

11/18 Narmation 2166

6" @ 2166'

T.D. 2194

40 qts. 2173-89

Pump 35 Pot.

Gravity 36

COMPLETED

Butler

Map No. 14 Sec. 21 Twp. 25 R. 5EWell No. 123 ChesneyCities Service Oil CompanyFIRST REPORT Contractor

NW SW NE

SECTION PLAT

 Ft. from N. Line990 Ft. from S. Line Ft. from E. Line330 Ft. from W. Line

		o	

MISCELLANEOUS

Location XXXRig up

Drilling and Remarks:

RECORD

Cased in., ft.Sand Gas Oil Total Depth

PRODUCTION

1st 24 hrs. Nat. 1st 24 hrs. after shot Gas Cu. Ft.Dry-Hole Abandoned

Date

OCT 21 1942 19S. J. LEWIS Scout

