

KANSAS

Bulter


FORM 51 5M 10-41 PETROL

Section 21 Township 25 Range 5-E

Well No. 124 Chasney

Company Cities Service Oil

NORTH

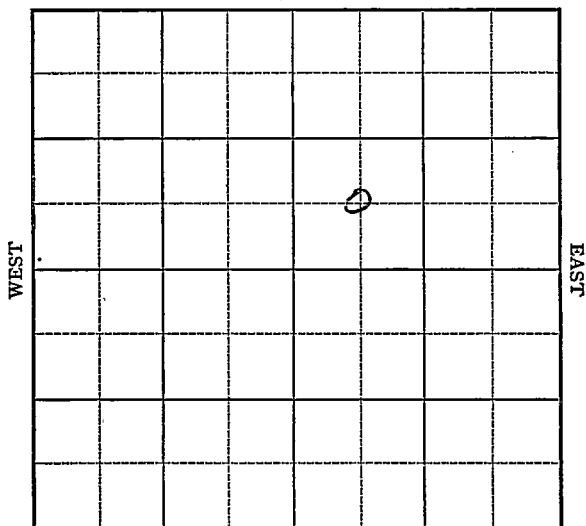

SOUTH

KANSAS

Butler

Sec. 21 Twp. 25 R. 5-EWell No. #124 Chesney Farm

Cities Service Oil Company

Miscellaneous

Ft. from N. Line


660

Ft. from S. Line

Ft. from E. Line

760

Ft. from W. Line

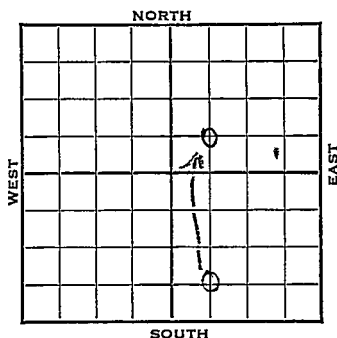

C SW 4NE

1942

REPORT

12/2

Loc.

12/9

Lans 1626

KC 1919

Warnation 2187

SD 2189-94

TD 2200

12/16

2000 acid

12/22

6" @ 2177' 30 qts. 2185-97

Pump 30 bbls oil in 8 hrs.

12/29

Narmation 2177

6" @ 2177'

T.D. 2200'

30 qts. 2185-97

2000 gals. acid

Pump 30 Pot.

Gravity 36.4

COMPLETED

Butler

KANSAS

Map No. 14 Sec. 21 Twp. 25 R. 5EWell No. 124 ChasneyCities Service Oil CompanyCORRECTION ContractorC SW ~~WEST~~ REPORT

Ft. from N. Line

660 Ft. from S. Line

Ft. from E. Line

760 Ft. from W. Line

SECTION PLAT

		0 1	
		0	

MISCELLANEOUS

Location _____

Rig up _____

Drilling and Remarks:

Had spotted
in SENeed
Completion
Ticket

RECORD

Cased 1 in., _____ ft.

Sand _____

Gas _____

Oil _____

Total Depth _____

PRODUCTION

1st 24 hrs. Nat. _____

1st 24 hrs. after shot _____

Gas _____ Cu. Ft.

Dry Hole _____

Abandoned _____

Date

DEC 2 1942 19 S. J. LEWIS Scout


KANSAS

Butler

Map No. 14 Sec. 21 Twp. 25 R. 5EWell No. 124 ChesneyCities Service Oil CompanyCOMPLETED Contractor

C SW NE

SECTION PLAT

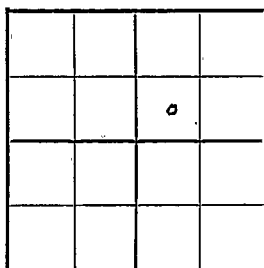 Ft. from N. Line660 Ft. from S. Line Ft. from E. Line760 Ft. from W. Line

MISCELLANEOUS

Location Rig up

Drilling and Remarks:

*Marmaton 2177**6" C 2177**309 ft 2185-97**2000 acid**Pump 30 Pst.**36 1/2 hr*

RECORD

Cased in., ft.Sand Gas Oil Total Depth 2200

PRODUCTION

1st 24 hrs. Nat. 1st 24 hrs. after shot Gas Cu. Ft.Dry Hole Abandoned

Date

DEC 29 1942 19 S. J. LEWIS Scout