


**KANSAS**

Butler county

Section 21 Township 25 Range 5-E

Well No. #126, Chesney

Company Cities Service Oil Company

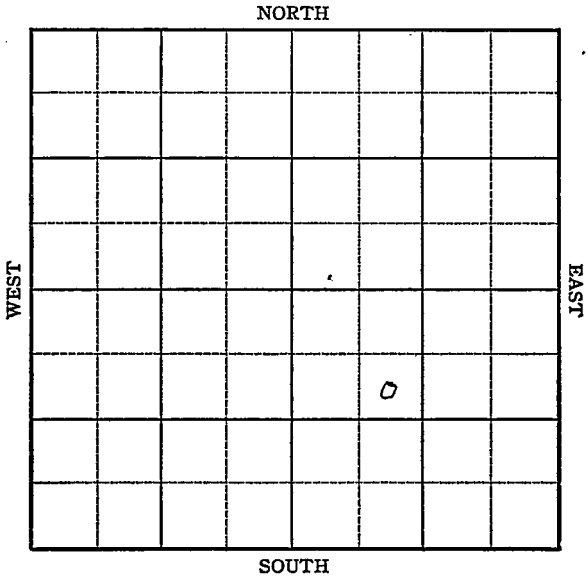

KANSAS

Butler County ✓

Sec. 21 Twp. 25 R. 5E

Well No. #126 Chesney Farm

Cities Service Company

Miscellaneous


990 Ft. from N. Line

Ft. from S. Line

Ft. from E. Line

990 Ft. from W. Line

SE NW SE

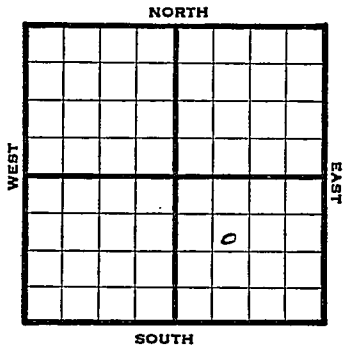

1946 Elev. 1390' REPORT

- 9/25 RUR
- 10/1 Lans 1625'  
Drlg 1692'
- 10/8 KC 1914  
Drlg 2186'
- 10/15 Arb 2366-88 TD  
5" @ 2369' RUST
- 10/22 " "
- 10/30 Arb 2366'  
5" @ 2369'  
Pump 130 POT  
TD 2407'  
39 Grav.

COMPLETED

KANSAS Kansas Pool Name Miscellaneous  
 Map No. 17 Sec. 21 Twp. 25 R. 5E

Well No. 126 Chesney

Cities Service Company

FIRST REPORT Contractor

SE NW SE

SECTION PLAT

990 Ft. from N. Line

\_\_\_\_\_ Ft. from S. Line

\_\_\_\_\_ Ft. from E. Line

990 Ft. from W. Line

		0	

Butler County

Location \_\_\_\_\_

Rig up \_\_\_\_\_

Drilling and Remarks:

R U R

RECORD

Cased \_\_\_\_\_ in., \_\_\_\_\_ ft.

Sand \_\_\_\_\_

Gas \_\_\_\_\_

Oil \_\_\_\_\_

Total Depth \_\_\_\_\_

PRODUCTION

1st 24 hrs. Nat. \_\_\_\_\_

1st 24 hrs. after shot \_\_\_\_\_

Gas \_\_\_\_\_ Cu. Ft.

Dry Hole \_\_\_\_\_

Abandoned \_\_\_\_\_

Date

SEP 25 1946 19

S. J. LEWIS Scout

Form 26 200 Bks. 10-46 Petrol  
KansasMap No. 14 Sec. 21 Twp. 25 R. 511Well No. 126 Chesney

Cities Service \_\_\_\_\_ Company

**COMPLETED**

Contractor

SE NW SE

E11890

SECTION PLAT

990 Ft. from N. Line

\_\_\_\_\_ Ft. from S. Line

\_\_\_\_\_ Ft. from E. Line

990 Ft. from W. Line


Butler County

Location \_\_\_\_\_

Rig up \_\_\_\_\_

Drilling and Remarks:

Cr 23665" @ 2369Pump 130 5039-1/4

## RECORD

Cased \_\_\_\_\_ in., \_\_\_\_\_ ft.

Sand \_\_\_\_\_

Gas \_\_\_\_\_

Oil \_\_\_\_\_

Total Depth 2407

## PRODUCTION

1st 24 hrs. Nat. \_\_\_\_\_

1st 24 hrs. after shot \_\_\_\_\_

Gas \_\_\_\_\_ Cu. Ft.

Dry Hole \_\_\_\_\_

Abandoned \_\_\_\_\_

Date

OCT 30 1946 19 \_\_\_\_\_

S. J. LEWIS Scout