

# KANSAS


FORM 51 IOM 12-46 PETROL

Butler county

Section 21 Township 25 Range 5-E

Well No. #129, Chesney

Company Cities Service Oil Company

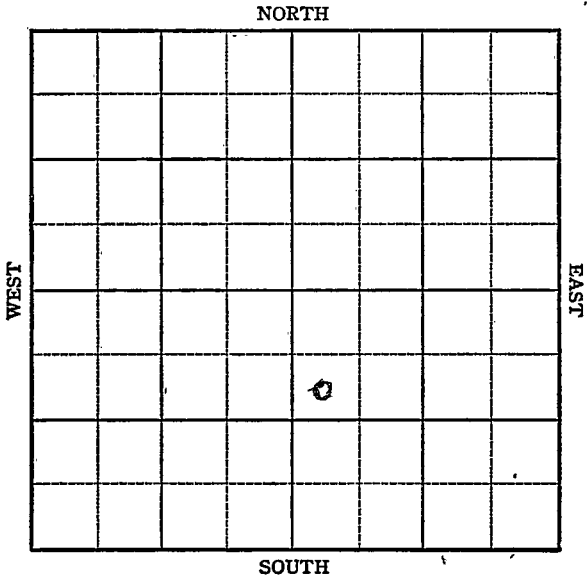


Sec. 21 **KANSAS** Twp. 25 R. 5-E

Well No. #129, Chesney Farm  
**Cities Service Oil Company** Company

Miscellaneous

990' Ft. from N. Line  
 \_\_\_\_\_ Ft. from S. Line  
 \_\_\_\_\_ Ft. from E. Line  
330' Ft. from W. Line

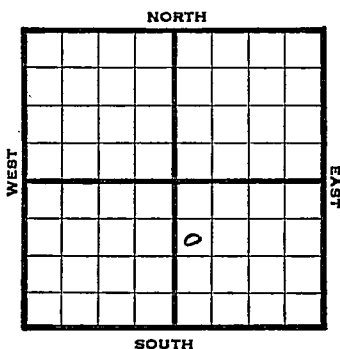

SW NW SE

1946 Elev. 1379 REPORT

12/18 Spud

1947

1/4 Lans 1622, KC 1927'  
 Drlg 2035'

1/8 Arb 2351-58 TD SO  
 5" @ 2354 RUST

1/15 Arb 2351'  
 5" @ 2354  
 TD 2404'  
 38-GR  
 Pump 100 POT

**COMPLETED**

Map No. \_\_\_\_\_ Sec. 21 Twp. 25 R. 5E

Well No. 129 Chesney

Cities Service Company

**FIRST REPORT** Contractor

SW NW SE

**SECTION PLAT**

990 Ft. from N. Line

\_\_\_\_\_ Ft. from S. Line

\_\_\_\_\_ Ft. from E. Line

330 Ft. from W. Line


Butler County

Location \_\_\_\_\_

Rig up \_\_\_\_\_

Drilling and Remarks:

Spud

**RECORD**

Cased \_\_\_\_\_ in., \_\_\_\_\_ ft.

Sand \_\_\_\_\_

Gas \_\_\_\_\_

Oil \_\_\_\_\_

Total Depth \_\_\_\_\_

**PRODUCTION**

1st 24 hrs. Nat. \_\_\_\_\_

1st 24 hrs. after shot \_\_\_\_\_

Gas \_\_\_\_\_ Cu. Ft.

Dry Hole \_\_\_\_\_

Abandoned \_\_\_\_\_

Date

DEC 1 8 1946 19

S. J. LEWIS Scout

14

**KANSAS**  
Kansas

Map No. 14 Sec. 21 Twp. 25 R. 5E

Well No. 129 Chesney

Cities Service Company

**COMPLETE**

Contractor

SW NW SE

*E. I. B. 79*

**SECTION PLAT**

990 Ft. from N. Line

         Ft. from S. Line

         Ft. from E. Line

330 Ft. from W. Line


Butler County

Location                                 

Rig up                                 

Drilling and Remarks:

*Ter 42351*

*5' to 2354*

*Pump 100 100*

*08-1-19*

**RECORD**

Cased          in.,          ft.

Sand                                 

Gas                                 

Oil                                 

Total Depth 2404

**PRODUCTION**

1st 24 hrs. Nat.                                 

1st 24 hrs. after shot                                 

Gas                                  Cu. Ft.

Dry Hole                                 

Abandoned                                 

Date

JAN 15 1947 19

S. J. LEWIS Scout