


Section 21 Township 25 Range 5-E

Well No. #130, Chesney

Company Cities Service Oil Company

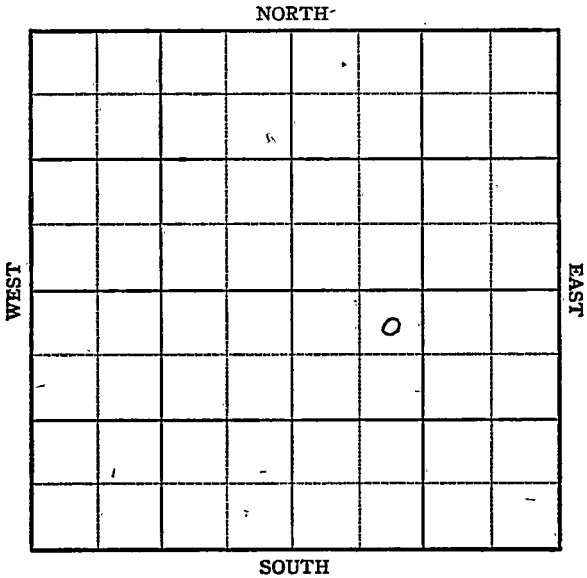

KANSAS

Sec. 21 Twp. 25 R. 5-E

Well No. #130, Chesney (Twin) Farm

Cities Service Oil Company Company


Miscellaneous

330' Ft. from N. Line

Ft. from S. Line

Ft. from E. Line

990' Ft. from W. Line

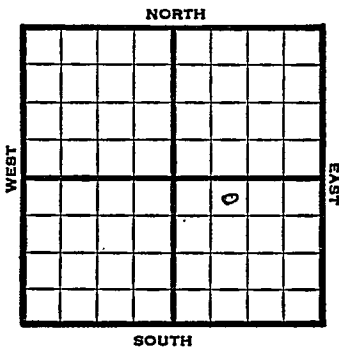

NE NW SE

SOUTH

1947

1377

REPORT

1/22 Location

2/12 Arb. 2352
5" @ 2355
Pump 117 Pot
Grav. 38
TD 2408'

COMPLETED

KANSAS

Map No. 14 Sec. 21 Twp. 25 R. 5EWell No. 130 ChesneyCities Service Company**FIRST REPORT** Contractor

NE. NW SE

SECTION PLAT

330 Ft. from N. Line Ft. from S. Line Ft. from E. Line990 Ft. from W. Line

		c	

Butler County

Location XRig up

Drilling and Remarks:

twin well

RECORD

Cased in., ft.Sand Gas Oil Total Depth

PRODUCTION

1st 24 hrs. Nat. 1st 24 hrs. after shot Gas Cu. Ft.Dry Hole Abandoned

Date

JAN 22 1947

19

S. J. LEWIS

Scout

Kansas

Map No. 14 Sec. 21 Twp. 25 R. 5EWell No. 130 Chesney

Cities Service Company

COMPLETE

Contractor

NE NW SE

SECTION PLAT

330 Ft. from N. Line Ft. from S. Line Ft. from E. Line990 Ft. from W. Line

		o	

Butler County

Location Rig up

Drilling and Remarks:

*CE 2352**5" @ 2355**Pump 117 Bt**380 lb*

RECORD

Cased in, ft.Sand Gas Oil Total Depth 2408

PRODUCTION

1st 24 hrs. Nat. 1st 24 hrs. after shot Gas Cu. Ft.Dry Hole Abandoned

Date

FEB 12 1947 19

S. J. LEWIS Scout