

KANSAS


FORM 51 IOM 12-46 PETROL

Butler

Section 21 Township 25 Range 5-E

Well No. #131 Chasney

Company Cities Service

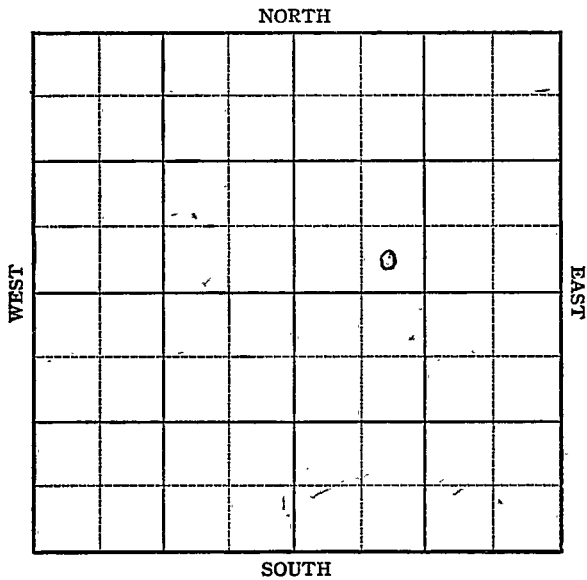

KANSAS

Butler

Sec. 21 Twp. 25 R. 5-E

Well No. #131 Chesney Farm

Cities Service Company


Miscellaneous

 Ft. from N. Line

330 Ft. from S. Line

 Ft. from E. Line

990 Ft. from W. Line

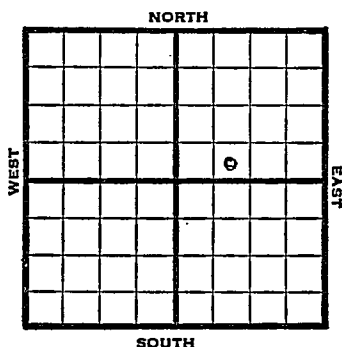

SE SW NE

1947 1370 REPORT

2/19 Location

2/26 Drlg 230'

3/4 Drlg 1990'

3/11 Arb 2370-2380
TD 2380'
5" @ 2375
RUST

3/19 Arb 2370
5" @ 2375
Pump 90 Pot
Grav. 39
TD 2408'

COMPLETED

Map No. 1 4 Sec. 2E Twp. 25 R. 5E

Well No. 131 Chesney

Cities Service Company

FIRST REPORT Contractor

SE SW NE


SECTION PLAT

 Ft. from N. Line

330 Ft. from S. Line

 Ft. from E. Line

990 Ft. from W. Line

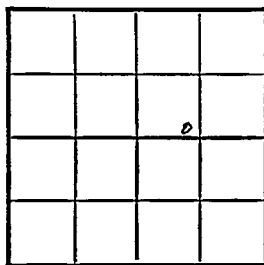

Butler County

Location X

Rig up

Drilling and Remarks:

RECORD

Cased 14 1/2 in. ft.

Sand

Gas

Oil

Total Depth

PRODUCTION

1st 24 hrs. Nat.

1st 24 hrs. after shot

Gas Cu. Ft.

Dry Hole

Abandoned

Date

FEB 1 9 1947 19 S. I. LEWIS Scout

Map No. 14 Sec. 21 Twp. 25 R. 5EWell No. 131 ChesneyCities Service

Company

COMPLETE

Contractor

SE SW NE

E/1370
SECTION PLAT

		0	

Ft. from N. Line330 Ft. from S. LineFt. from E. Line990 Ft. from W. LineButler County

Location _____

Rig up _____

Drilling and Remarks:

Pr 823705102375Pr 90 BX(39 2/3)

RECORD

Cased _____ in., _____ ft.

Sand _____

Gas _____

Oil _____

Total Depth 2408

PRODUCTION

1st 24 hrs. Nat. _____

1st 24 hrs. after shot _____

Gas _____ Cu. Ft.

Dry Hole _____

Abandoned _____

Date

MAR 19 1947

19

S. J. LEWIS

Scout