

KANSAS

Butler


FORM 51 IOM 12-46 PETROL

Section 21 Township 25 Range 5E

Well No. 133 Chesney

Company Cities Service

Misc.

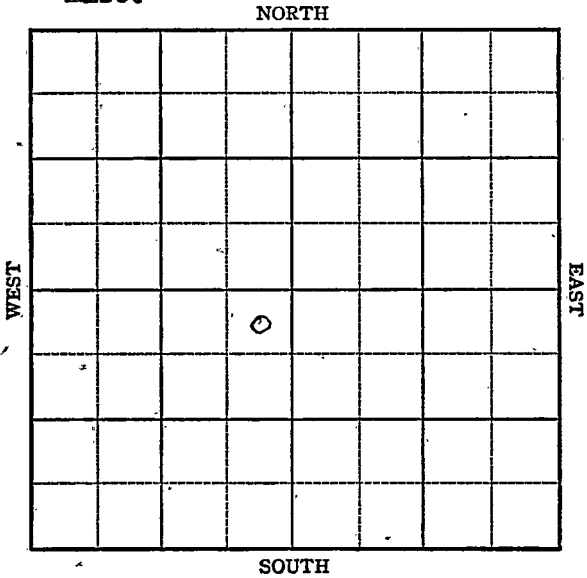

Sec. 21 Twp. 25 R. 5E

Well No. #133 Chesney Farm

Cities Service Company
Miscellaneous


330 Ft. from N. Line

 Ft. from S. Line

330 Ft. from E. Line

 Ft. from W. Line

NE SW

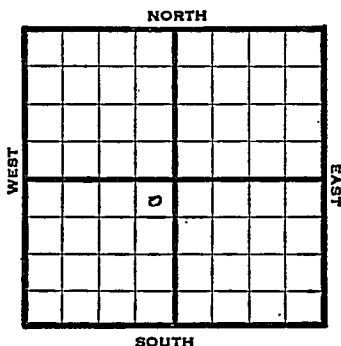

1947

Elev. 1374

REPORT

4/2 Drlg. 700'.

4/9 Lansing 1639'
KO 1939'
Drlg. 1980'

4/15 Arbuckle 2391'
5" @ 2394'
Drlg. 2475'

4/23 TD 281'
Pump 24 bbls oil & 58 W 24 hrs

4/29 TD 2491'

5/7 Arb 2391'
5" @ 2394'
Pump 80 oil & 105 W Pot
Grav. 38'
TD 2491'

COMPLETED

Map No. K14 Sec. 21 Twp. 25 R. 5E

Well No. 133 Chesney

Cities Service Company
FIRST REPORT

Contractor

NE SW

SECTION PLAT

330 Ft. from N. Line

 Ft. from S. Line

330 Ft. from E. Line

 Ft. from W. Line

	o		

Butler County

Location

Rig up

Drilling and Remarks:

drlg. 700'

RECORD

Cased in, ft.

Sand

Gas

Oil

Total Depth

PRODUCTION

1st 24 hrs. Nat.

1st 24 hrs. after shot

Gas Cu. Ft.

Dry Hole

Abandoned

Date

APR 2 1947 19

S. J. LEWIS Scout

Kansas KANSAS

Map No. K 14 Sec. 21 Twp. 25 R. 5EWell No. 133 Chesney

Cities Service Company

COMPLETE

Contractor

NE SW

E 1, 1974
SECTION PLAT330 Ft. from N. Line Ft. from S. Line330 Ft. from E. Line Ft. from W. Line

	6		

Butler County

Location Rig up

Drilling and Remarks:

Cr 23915" @ 2384Pump 80 oil +
105W Oil380 Gr

RECORD

Cased in, ft.Sand Gas Oil Total Depth 2491

PRODUCTION

1st 24 hrs. Nat. 1st 24 hrs. after shot Gas Cu. Ft.Dry Hole Abandoned

Date

MAY 7 1947 19

S. J. LEWIS Scout