KANSAS


Form 51—5M—7-40—Palace

Ellsworth

Section 35 Township 16 Range 10-W

Well No. #4 Ehler

Company Lauck & Moncrief et al

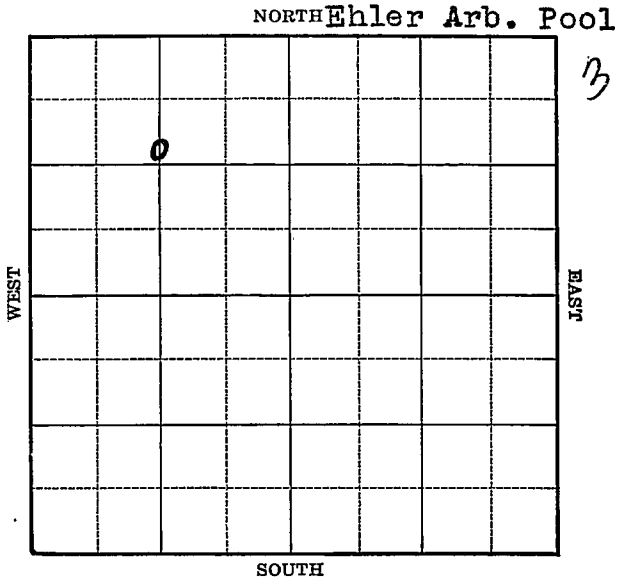

FORM 252-A 5M 2-40

KANSAS Ellsworth

Sec. 35 Twp. 16 R. 10-W

Well No. #4 Ehler Farm

Lauck & Moncrief et al Company


(Ehler Arb. Pool)

1237 Ft. from N. Line

Ft. from S. Line

Ft. from E. Line

1320 Ft. from W. Line

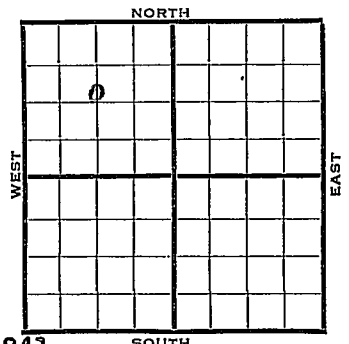

Elev. 1841

1940	REPORT
7/31	Rotary Derrick.
8/8	XXXX 10" - 159' Anhy 603'
	Drlg. 700'
8/14	Drlg. 2555'
8/22	Arb. ~~3309'~~ 3312' T.D. 3313'
	7" - ~~3309'~~ 3312' RUST.
8/28	Arb. 3312 7" 3312 T.D. 3339
	1000 acid
	Pump 22 Pot.
	COMPLETED

Form 26—200 Bks.—1-40—Palace Ellsworth KANSAS

Map No. 555 Sec. 35 Twp. 16 R. 10W

Well No. 4 Ehler

Lauck & Moncrief etal Company

Contractor

FIRST REPORT

C NW

1237 Ft. from N. Line


Ft. from S. Line

Ft. from E. Line

1320 Ft. from W. Line

EHLER ARB POOL

SECTION PLAT

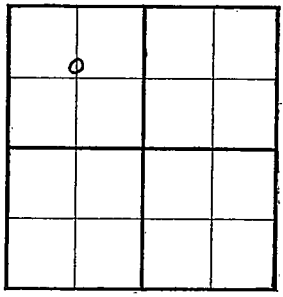

Location

Rig up

Drilling and Remarks:

Roty. Derrick

RECORD

Cased in., ft.

Sand

Gas

Oil

Total Depth

PRODUCTION

1st 24 hrs. Nat.

1st 24 hrs. after shot

Gas Cu. Ft.

Dry Hole

Abandoned

Date

JUL 31 1919

S. J. LEWIS Scout

Form 26—200 Blank—1-40—Palace KANSAS Ellsworth

Map No. _____ Sec. 35 Twp. 16 R. 10W

Well No. 4 Ehler

Lauck & Moncrief etal Company

Contractor

COMPLETED

C NW

1237 Ft. from N. Line


_____ Ft. from S. Line

_____ Ft. from E. Line

1320 Ft. from W. Line

EHLER POOL

SECTION PLAT

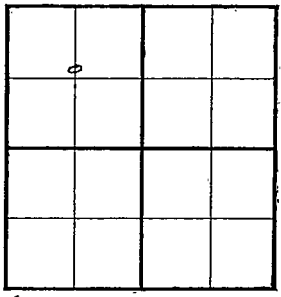

Location _____

Rig up _____

Drilling and Remarks:

Ran 3312.
7" @ 3312
1000 acid
Pump 22 BO.

RECORD

Cased _____ in., _____ ft.

Sand _____

Gas _____

Oil _____

Total Depth 3239

PRODUCTION

1st 24 hrs. Nat. _____

1st 24 hrs. after shot _____

Gas _____ Cu. Ft.

Dry Hole _____

Abandoned _____

Date

AUG 28 1940 19

S. J. LEWIS Scout