

# KANSAS

Form 51-5M-7-40-Palace


Ellsworth

Section 35 Township 16 Range 10-W

Well No. #1 Hans Ehler

Company Aylward Prod.

NORTH Ehler Pool

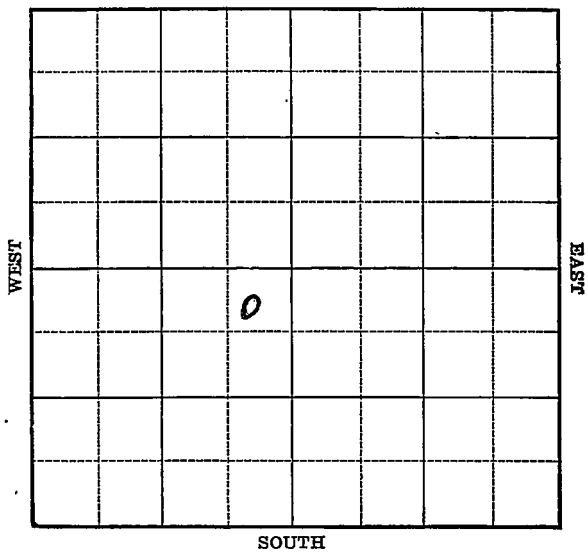

Sec. 35 Twp. 16 R. 10-W

Well No. #1 Hans Ehler Farm

Aylward Prod. Company

(Ehler)


467 Ft. from N. Line

\_\_\_\_\_ Ft. from S. Line

440 Ft. from E. Line

\_\_\_\_\_ Ft. from W. Line

Elev. 1831

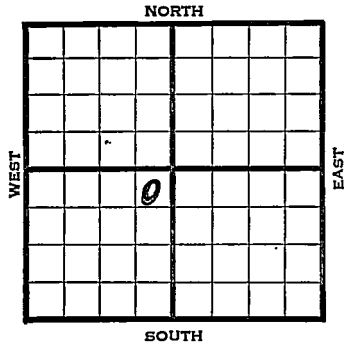

1940	REPORT
10/2	10" - 170' 665' WOC.
10/10	Drlg. 2525'
10/17	Arb. 3284-88' T.D. 5" - 328 7' RUST.
10/23	Arb. 3284'
	5" - 328 7'
	T.D. 3314'
	3000 acid.
	Depthograph potential 2753 bbls.
	<b>COMPLETED</b>



Map No. 35 Sec. 35 Twp. 16 R. 10W

Well No. 1 Hans Ehler

Aylward Production Company

Contractor

**COMPLETED**

NE SW

467 Ft. from N. Line

\_\_\_\_\_ Ft. from S. Line

440 Ft. from E. Line

\_\_\_\_\_ Ft. from W. Line

**EHLER POOL**

**SECTION PLAT**

	o		

Location \_\_\_\_\_

Rig up \_\_\_\_\_

Drilling and Remarks:

*Ar 8 3284*  
*5" @ 287.*  
*3000 acid*  
*Depth 2753. 80*

**RECORD**

Cased \_\_\_\_\_ in., \_\_\_\_\_ ft.

Sand \_\_\_\_\_

Gas \_\_\_\_\_

Oil \_\_\_\_\_

Total Depth 3314

**PRODUCTION**

1st 24 hrs. Nat. \_\_\_\_\_

1st 24 hrs. after shot \_\_\_\_\_

Gas \_\_\_\_\_ Cu. Ft.

Dry Hole \_\_\_\_\_

Abandoned \_\_\_\_\_

Date

OCT 23 1940 19

S. I. LEWIS Scout