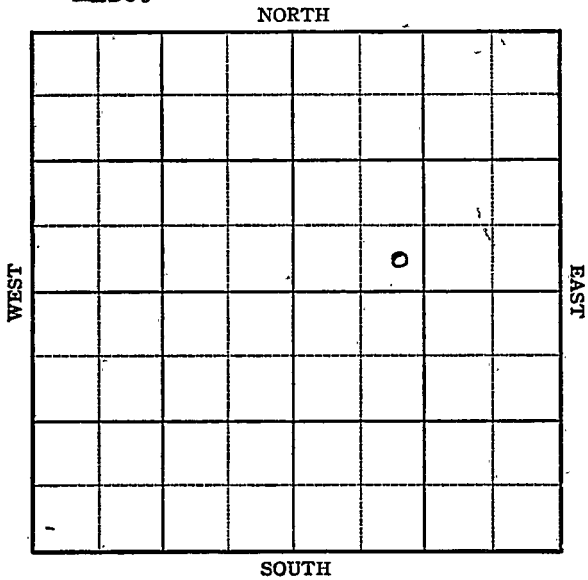


KANSAS

FORM 51 IOM 12-46 PETROL

Butler

Section 21 Township 25 Range 5EWell No. 134 ChesneyCompany Cities Service
Misc.

KANSAS

Butler ✓

Sec. 21 Twp. 25 R. 5E

Well No. #134 Chesney Farm

Cities Service Company

Miscellaneous

 Ft. from N. Line


330 Ft. from S. Line

 Ft. from E. Line

1090 Ft. from W. Line

SE SW NE

TWIN

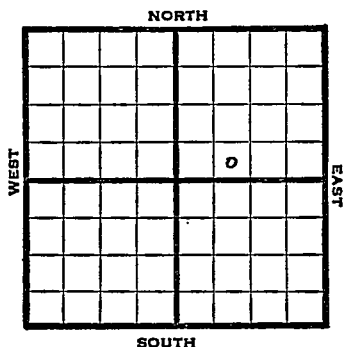

1947 Elev. 1371

REPORT

4/2 Location

4/9 "

4/15 Douglas 1440'
TD 1442' SO
5" @ 1441'
RUST

4/23 SD

4/30 Douglas 1440'
5" @ 1441
Pump 130 Pot
Grav. 36
TD 1480'

COMPLETED

Map No. A14 Sec. 21 Twp. 25 R. 5E

Well No. 134 Chesney

Cities Service Company

FIRST REPORT Contractor

SE SWNE


SECTION PLAT

 Ft. from N. Line

330 Ft. from S. Line

 Ft. from E. Line

1090 Ft. from W. Line

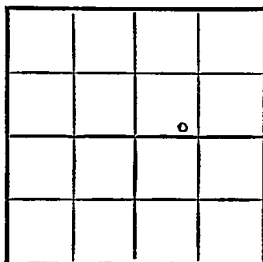

Butler County

Location X

Rig up

Drilling and Remarks:

twin well

RECORD

Cased in., ft.

Sand

Gas

Oil

Total Depth

PRODUCTION

1st 24 hrs. Nat.

1st 24 hrs. after shot

Gas Cu. Ft.

Dry Hole

Abandoned

Date

APR 2 1947 19

S. J. LEWIS Scout

Map No. K 14 Sec. 21 Twp. 25 R. 5E

Well No. 134 Chesney

Cities Service Company

COMPLETE

Contractor

SE SW NE

E. 1371


SECTION PLAT

 Ft. from N. Line

330 Ft. from S. Line

 Ft. from E. Line

1090 Ft. from W. Line

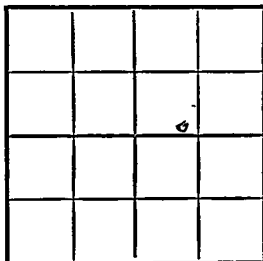

Butler County

Location

Rig up

Drilling and Remarks:

Dangle 1440
5' @ 1441
Pump 130 BX

36 2/34

RECORD

Cased in., ft.

Sand

Gas

Oil

Total Depth 1480

PRODUCTION

1st 24 hrs. Nat.

1st 24 hrs. after shot

Gas Cu. Ft.

Dry Hole

Abandoned

Date

APR 30 1947 19

S. J. LEWIS

Scout