


KANSAS

Ellsworth County

Section 35 Township 16 Range 10-W

Well No. #6, ~~Elmer~~ ^{Epler}

Company Ayward Prod.

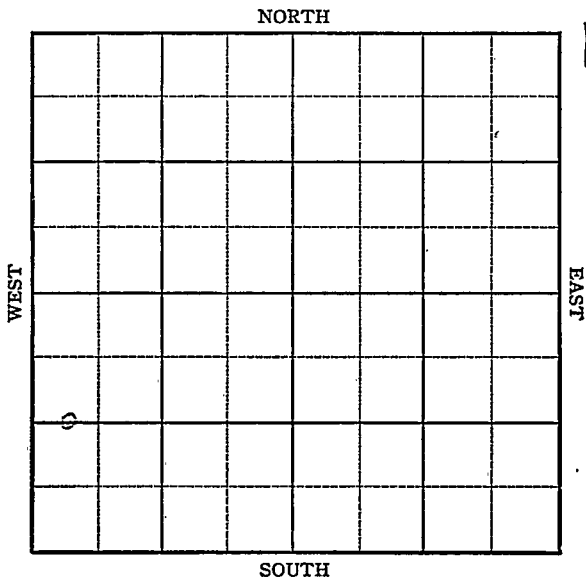

12

KANSAS

Ellsworth

Sec. 35 Twp. 16 R. 10W

Well No. #6 Ehler Farm

Aylward Prod Company


Bloomer

1390 Ft. from N. Line

Ft. from S. Line

Ft. from E. Line

400 Ft. from W. Line

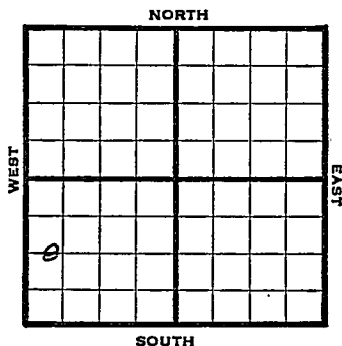

C W L SW

1946	Elev. 1823	REPORT
11/6	Drlg 1200'	
11/12	8" @ 225'	
	Anhy 590'	
	Drlg 3024'	
11/20	Lans 2965'	
	Arb 3272'	
	TD 3274'	
	5" @ 3273, RUST	
11/27	TD 3301, swb 24 oil in 16 hrs	
12/3	"	"
12/10	"	"
12/17	"	"
1947		
1/4	TD 3301', swb 24 oil in 16 hrs	
1/8	"	"
1/15	"	"
1/21	"	"
2/5	TD 3301'	
	Arb 3272'	
	5" @ 3273	
	Pump 77 Pot	
	Grav. 42	

COMPLETED

Map No. 55 Sec. 35 Twp. 16 R. 10W

Well No. 6 Ehler

Aylward Prod. Company

FIRST REPORT Contractor

C W L SW


SECTION PLAT

1390 Ft. from N. Line

 Ft. from S. Line

 Ft. from E. Line

400 Ft. from W. Line

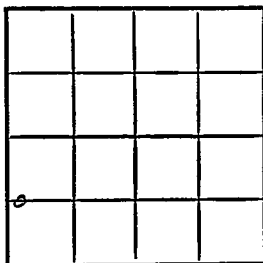

Ellsworth County

Location

Rig up

Drilling and Remarks:

drlg. 1200

RECORD

Cased in., ft.

Sand

Gas

Oil

Total Depth

PRODUCTION

1st 24 hrs. Nat.

1st 24 hrs. after shot

Gas Cu. Ft.

Dry Hole

Abandoned

Date

NOV 6 1946 19 S. J. LEWIS Scout

Map No. 55 Sec. 35 Twp. 16 R. 10W

Well No. 6 Ehler

Aylward Prod. Company

COMPLETE

Contractor

C W L SW


E1, 1823
SECTION PLAT

1390 Ft. from N. Line

 Ft. from S. Line

 Ft. from E. Line

400 Ft. from W. Line

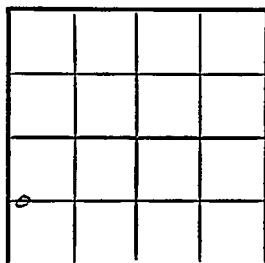

Ellsworth County

Location

Rig up

Drilling and Remarks:

See 80272

5' @ 80273

Pump 77 P.D.

420 Gr

RECORD

Cased in., ft.

Sand

Gas

Oil

Total Depth 2301

PRODUCTION

1st 24 hrs. Nat.

1st 24 hrs. after shot

Gas Cu. Ft.

Dry Hole

Abandoned

Date

FEB 5 1947 19

S. J. LEWIS Scout