

KANSAS

Form 51-5M-7-40-Palace


Ellsworth

Section 35 Township 16 Range 10-W

Well No. #5 Mehl

Company Lario

NORTH Ehler Pool

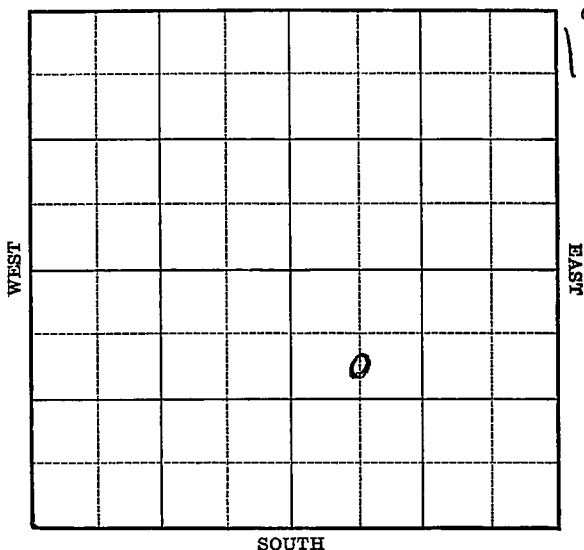

Map No. 55 Sec. 35 Twp. 16 R. 10WWell No. 5 MehlLario

Company

Contractor

FIRST REPORT**C SLNW SE**990 Ft. from N. Line Ft. from S. Line Ft. from E. Line660 Ft. from W. Line**EHLER POOL****SECTION PLAT**

Location Rig up

Drilling and Remarks:

Rotary**RECORD**Cased in., ft.Sand Gas Oil Total Depth **PRODUCTION**1st 24 hrs. Nat. 1st 24 hrs. after shot Gas Cu. Ft.Dry Hole Abandoned

Date

OCT 2 1940S. J. LEWIS Scout

Map No. 55 Sec. 35 Twp. 16 R. 10WWell No. 5 MehlLario

Company

~~COMPLETED~~

Contractor

C S L NW SE

SECTION PLAT

990 Ft. from N. Line Ft. from S. Line Ft. from E. Line660 Ft. from W. Line

EHIER POOL

Location Rig up

Drilling and Remarks:

*Cr 8286**5" @ 8287 1/2**2500 acvil**Depth 822704**Max 3000*

RECORD

Cased in., ft.Sand Gas Oil Total Depth 3300

PRODUCTION

1st 24 hrs. Nat. 1st 24 hrs. after shot Gas Cu. Ft.Dry Hole Abandoned

Date

OCT 23 1940

S. J. LEWIS Scout