SIDE ONE

STATE CORPORATION COMMISSION OF KANSAS
OIL & GAS CONSERVATION DIVISION
WELL COMPLETION OR RECOMPLETION FORM
ACO-1 WELL HISTORY
DESCRIPTION OF WELL AND LEASE

Operator: License # 5123
Name Pickrell Drilling Company, Inc.
Address 110 N. Market
Suite 205
City/State/Zip Wichita, KS 67202

Purchaser none

Operator Contact Person Jay McNeil
Phone 316-262-8427

Contractor: License # 5123
Name Pickrell Drilling Company, Inc.

Wellsite Geologist Billy G. Klaver
Phone 721-4051

Designate Type of Completion
X New Well ___ Re-Entry ___ Workover

___ Oil ___ SWD ___ Temp Abd
___ Gas ___ Inj ___ Delayed Comp.
X Dry ___ Other (Core, Water Supply etc.)

If OWWO: old well info as follows:
Operator
Well Name
Comp. Date Old Total Depth

WELL HISTORY

Drilling Method:
X Mud Rotary ___ Air Rotary ___ Cable

3-27-89	4-3-89	4-3-89
Spud Date	Date Reached TD	Completion Date

4325	
Total Depth	PBTD

Amount of Surface Pipe Set and Cemented at 233 feet
Multiple Stage Cementing Collar Used? ___ Yes ___ No
If yes, show depth set feet
If alternate 2 completion, cement circulated
from feet depth to w/ SX cmt
Cement Company Name
Invoice #

API NO. 15- 063-21,260

County Gove

NW. SW. NW. Sec 10 Twp 15S Rge 29 ___ East X West

3630 Ft North from Southeast Corner of Section
4950 Ft West from Southeast Corner of Section
(Note: Locate well in section plat below)

Lease Name Courtney Well # 1-A

Field Name Wildcat

Producing Formation none

Elevation: Ground 2571 KB 2576

KANSAS GEOLOGICAL SURVEY
WICHITA BRANCH
APR 26 1989

RECEIVED
STATE CORPORATION COMMISSION

CONSERVATION DIVISION
Wichita, Kansas

Section Plat

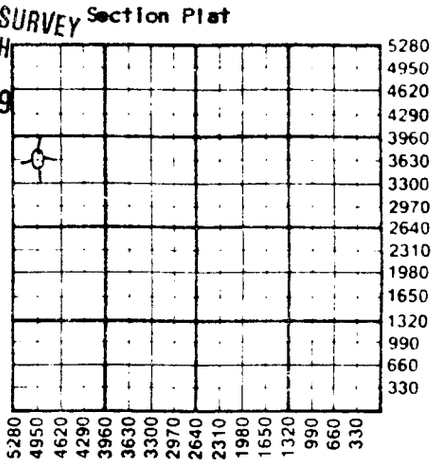

WATER SUPPLY INFORMATION

Disposition of Produced Water: ___ Disposal
Docket # ___ Repressuring

Questions on this portion of the ACO-1 call:
Water Resources Board (913) 296-3717

Source of Water:
Division of Water Resources Permit # T 89-135

X Groundwater 1400 Ft North from Southeast Corner
(Well) 5200 Ft West from Southeast Corner of
Sec 13 Twp 15S Rge 29 ___ East X West

___ Surface Water Ft North from Southeast Corner
(Stream, pond etc) Ft West from Southeast Corner
Sec Twp Rge ___ East ___ West

___ Other (explain)
(purchased from city, R.W.D. #)

INSTRUCTIONS: This form shall be completed in triplicate and filed with the Kansas Corporation Commission, 200 Colorado Derby Building, Wichita, Kansas 67202, within 120 days of the spud date of any well. Rule 82-3-130, 82-3-107 and 82-3-106 apply.
Information on side two of this form will be held confidential for a period of 12 months if requested in writing and submitted with the form. See rule 82-3-107 for confidentiality in excess of 12 months.
One copy of all wireline logs and drillers time log shall be attached with this form. Submit CP-4 form with all plugged wells. Submit CP-111 form with all temporarily abandoned wells.

All requirements of the statutes, rules and regulations promulgated to regulate the oil and gas industry have been fully complied with and the statements herein are complete and correct to the best of my knowledge.

Signature
Title C.W. Sebits, President Date 5-5-89

Subscribed and sworn to before me this 20th day of April
19 89.
Notary Public Katherine J. Rule
Katherine J. Rule
Date Commission Expires 6-29-92

KATHERINE J. RULE
NOTARY PUBLIC
STATE OF KANSAS
MY APPT. EXPIRES 6-29-92

K.C.C. OFFICE USE ONLY
(F) ✓ Letter of Confidentiality Attached
(C) ✓ Wireline Log Received
C ___ Drillers Timelog Received
Distribution
___ KCC ___ SWD/Rep ___ NGPA
✓ KGS ___ Plug ___ Other
(Specify)

Sec. 10 Twp 15 Rge 29W

Form ACO-1 (5-86)