

KANSAS


Form 51-5M-7-40-Palace

Ellsworth

Section 35 Township 16 Range 10-W

Well No. #4 Mehl

Company Lario Oil & Gas

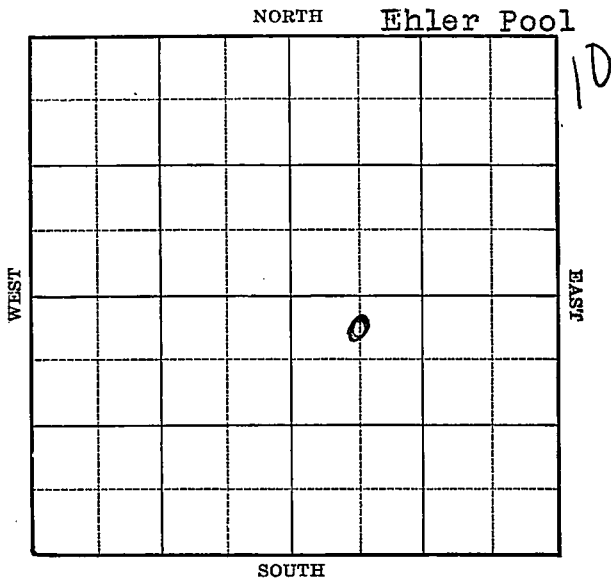

KANSAS

Ellsworth

FORM 252-A 5M 2-40

Sec. 35 Twp. 16 R. 10-WWell No. #4 Mehl FarmLario Oil & Gas

Company

(Ehler)

330

Ft. from N. Line


Ft. from S. Line

Ft. from E. Line

660

Ft. from W. Line

Elev. 1833

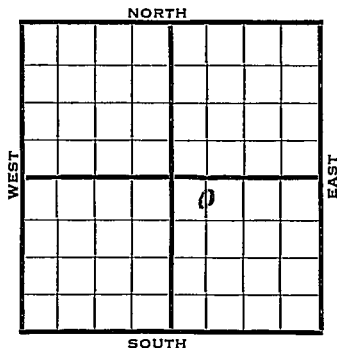

1940

REPORT

8/14 Rotary.

8/22 8" - 297' Drlg. 2440'

8/29 Lans. 2973' Arb. ~~3289~~¹/₂ 32885" - ~~3290~~³²⁸⁹ RUST.

9/4 Arb. 3288' (Corrected)

5" - 3289'

T.D. 3294'

Echometer potential 4727 bbls.

Maximum 3000 bbls.

COMPLETED

Map No. _____ Sec. 35 Twp. 16 R. 10WWell No. 4 Mehl_____
Lario Oil & Gas Company_____
Contractor

SECTION PLAT

330 C N L NW SE
Ft. from N. Line_____
Ft. from S. Line_____
Ft. from E. Line660
Ft. from W. Line

		o	

EHLER POOL

Location _____

Rig up _____

Drilling and Remarks:

Rotary

RECORD

Cased _____ in., _____ ft.

Sand _____

Gas _____

Oil _____

Total Depth _____

PRODUCTION

1st 24 hrs. Nat. _____

1st 24 hrs. after shot _____

Gas _____ Cu. Ft.

Dry Hole _____

Abandoned _____

Date

AUG 14 1940 19 _____ S. J. LEWIS Scout

Map No. _____ Sec. 35 Twp. 16 R. 10WWell No. 4 MehlLario Oil & Gas Company

Contractor _____

COMPLETED

C N L NW SE

330 Ft. from N. Line

_____ Ft. from S. Line

_____ Ft. from E. Line

660 Ft. from W. Line**SECTION PLAT**

		0	

EHLER POOL

Location _____

Rig up _____

Drilling and Remarks:

CE & 3288 connected
5" @ 3289

Echometer P & S
4727

*Max 3000***RECORD**

Cased _____ in., _____ ft.

Sand _____

Gas _____

Oil _____

Total Depth 3294**PRODUCTION**

1st 24 hrs. Nat. _____

1st 24 hrs. after shot _____

Gas _____ Cu. Ft.

Dry Hole _____

Abandoned _____

Date

SEP 4 1940 19S. J. LEWIS Scout