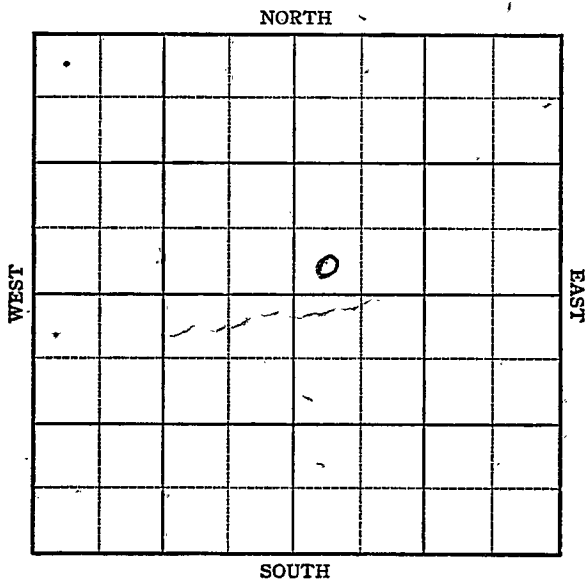


KANSAS

Butler

FORM 51 IOM 12-46 PETROL

Section 21 Township 25 Range 5EWell No. 137 ChesneyCompany Cities Service

KANSAS

Butler

Sec. 21 Twp. 25 R. 5-E

Well No. #137 Chesney (Twin) Farm

Cities Service

Company

Miscellaneous


 Ft. from N. Line

330 Ft. from S. Line

 Ft. from E. Line

330 Ft. from W. Line

SW NE

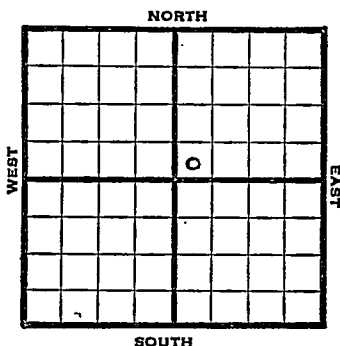

~~1947~~

REPORT

5/14	Location
5/20	"
5/27	"
6/3	"
6/10	RUR
6/17	Dr1g. 1488'
6/24	Arb. 2385' TD 2388' 5" @ 2387' RUST
7/2	Arb. 2385' 5" @ 2387' Pump 100 Pot 38.0 Gr. TD 2445'

COMPLETED


Map No. 1514 Sec. 21 Twp. 25 R. 5EWell No. 137 ChesneyCities Service Company

FIRST REPORT

Contractor

SW NE

SECTION PLAT

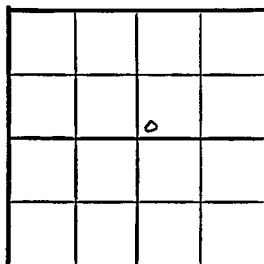 Ft. from N. Line330 Ft. from S. Line Ft. from E. Line330 Ft. from W. LineButler CountyLocation XRig up

Drilling and Remarks:

Twin well

RECORD

Cased in., ft.Sand Gas Oil Total Depth

PRODUCTION

1st 24 hrs. Nat. 1st 24 hrs. after shot Gas Cu. Ft.Dry Hole Abandoned

Date

MAY 14 1947

19

S. J. LEWIS

Scout

Map No. 14 Sec. 21 Twp. 25 R. 5EWell No. 137 ChesneyCities Service CompanyCOMPLETE Contractor

SW NE

SECTION PLAT

		o	

 Ft. from N. Line330 Ft. from S. Line Ft. from E. Line330 Ft. from W. Line

Butler County

Location Rig up

Drilling and Remarks:

*Cr 2385**5" @ 2387**Pump 100 ft**2382 ft*

RECORD

Cased in., ft.Sand Gas Oil Total Depth 2445

PRODUCTION

1st 24 hrs. Nat. 1st 24 hrs. after shot Gas Cu. Ft.Dry Hole Abandoned

Date

JUL 2 1947 19S. J. LEWIS

Scout