


Section 9 Township 18 Range 1W

Well No. 2 Tecter

Company Barbara Oil

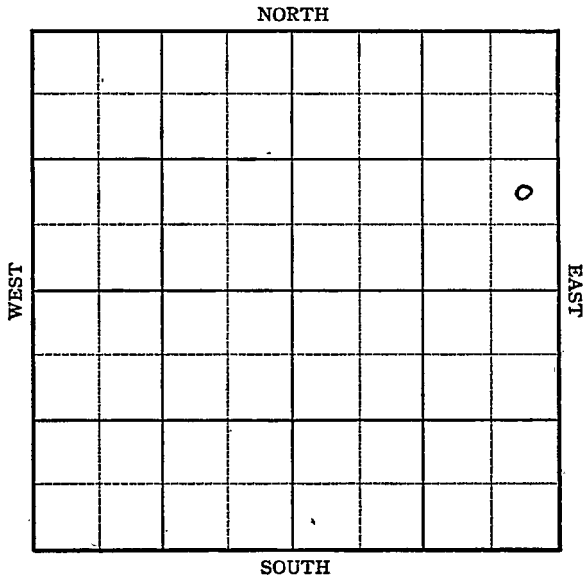

KANSAS

McPherson County

Sec. 9 Twp. 18 R. 1W

Well No. #2 Tector Farm

Barbara Oil Company


Canton

Ft. from N. Line

990 Ft. from S. Line

330 Ft. from E. Line

Ft. from W. Line

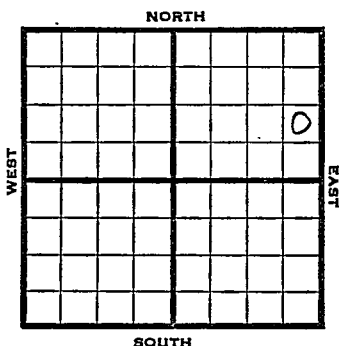

NE SE NE

1946

Elev. 1366

REPORT

5/8

Location

5/14

Miss 2678

TD 2680 SO

5" @ 2679 R^UST

5/21

TD 2696 $\frac{1}{2}$ -500' oil

1000 acid

5/29

3000 acid.

Pump 42 oil in 8 hrs.

6/5

Miss. 2678

5" @ 2679

TD 2696 $\frac{1}{2}$

4000 acid.

Pump 176 oil plus 5% W. Pot.

Grav. 38.0

COMPLETED

FOR

3 BKS 2-44 PETROL

GAS

Kansas Pool Name Canton

Map No. 42 Sec. 9 Twp. 18 R. 1W

Well No. 2 Tector

Barbara Oil Company

FIRST REPORT

Contractor

NE SE NE

SECTION PLAT

_____ Ft. from N. Line

990 Ft. from S. Line

330 Ft. from E. Line

_____ Ft. from W. Line

			o

McPherson County

Location _____

Rig up _____

Drilling and Remarks:

RECORD

Cased _____ in., _____ ft.

Sand _____

Gas _____

Oil _____

Total Depth _____

PRODUCTION

1st 24 hrs. Nat. _____

1st 24 hrs. after shot _____

Gas _____ Cu. Ft.

Dry Hole _____

Abandoned _____

Date

MAY 8 1946 19

S. J. LEWIS Scout

