

KANSAS

Form 51—5M—7-40—Palace


Ellsworth

Section 35 Township 16 Range 10-W

Well No. #6 Mehl

Company Lario

NORTH Ehler Pool

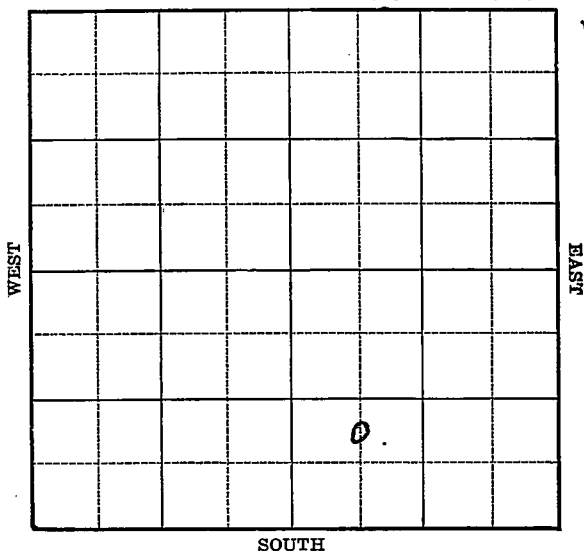

Map No. 55 Sec. 35 Twp. 16 R. 10WWell No. 6 MehlLario

Company

Contractor

FIRST REPORT

C N L SW SE

 Ft. from N. Line990 Ft. from S. Line Ft. from E. Line660 Ft. from W. Line

EHLER POOL

SECTION PLAT

		o	

Location Rig up

Drilling and Remarks:

Cellar

RECORD

Cased in., ft.Sand Gas Oil Total Depth

PRODUCTION

1st 24 hrs. Nat. 1st 24 hrs. after shot Gas Cu. Ft.Dry Hole Abandoned

Date

OCT 2 1940₁₉S. J. LEWIS Scout

Map No. 55 Sec. 35 Twp. 16 R. 10WWell No. 6 MehlLario Oil & Gas

Company

Contractor

COMPLETED
C N L SW SE**SECTION PLAT**

		0	

 Ft. from N. Line990 Ft. from S. Line Ft. from E. Line660 Ft. from W. Line

EHLER POOL

Location Rig up

Drilling and Remarks:

*Ce 8278**5 1/2" @ 3278**500 acid**Echo 8278/2028***RECORD**Cased in., ft.Sand Gas Oil Total Depth 3288**PRODUCTION**1st 24 hrs. Nat. 1st 24 hrs. after shot Gas Cu. Ft.Dry Hole Abandoned

Date

OCT 30 1940

19

S. J. LEWIS Scout