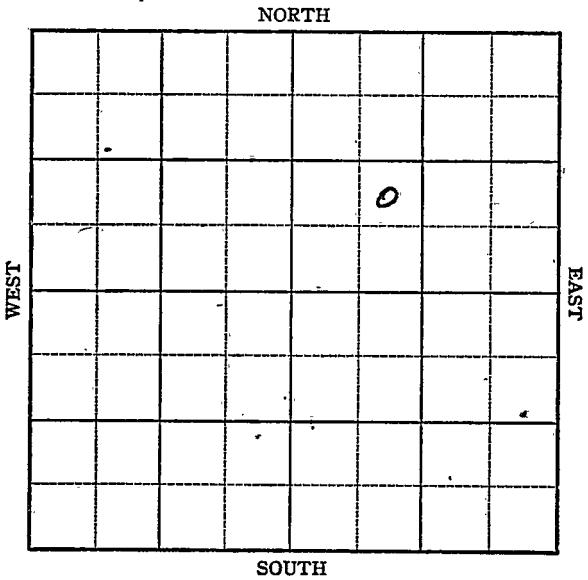


Section 21 Township 25 Range 5EWell No. 138 ChesneyCompany Cities Service

KANSAS 25

Butler county

21

Sec. Twp. R. 5E

Well No. 138 Chesney Farm

Cities Service Company

Miscellaneous

Ft. from N. Line


990

Ft. from S. Line

Ft. from E. Line

990

Ft. from W. Line

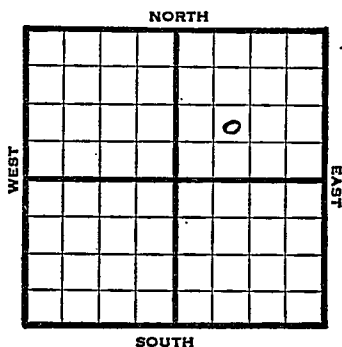

NE SW NE

1947

Elv. 1357' REPORT

6/25

RUR

7/1

Drlg 1440'

7/8

Douglas 1434'
Drlg. 1600'

7/16

Arbuckle 2374'
5" @ 2374'
Drlg 2408'
1800' oil

7/23

Arb. 2374'
5" @ 2374'
Pump 100 Pot.
Gr. 38
T.D. 2412'
Complete

COMPLETED

Map No. _____ Sec. 21 Twp. 25 R. 5E

Well No. 138 Chesney

_____ Cities Service _____ Company

FIRST REPORT

_____ Contractor

NE SW NE


SECTION PLAT

_____ Ft. from N. Line

990 Ft. from S. Line

_____ Ft. from E. Line

990 Ft. from W. Line

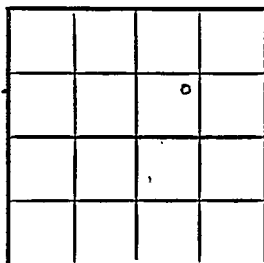

Butler County

Location _____

Rig up _____

Drilling and Remarks:

R U R

RECORD

Cased _____ in., _____ ft.

Sand _____

Gas _____

Oil _____

Total Depth _____

PRODUCTION

1st 24 hrs. Nat. _____

1st 24 hrs. after shot _____

Gas _____ Cu. Ft.

Dry Hole _____

Abandoned _____

Date

JUN 25 1947

19

S. J. LEWIS Scout

Map No. 14 Sec. 21 Twp. 25 R. 5EWell No. 138 ChesneyCities Service Company

COMPLETE

Contractor

NE SW NE

E11357
SECTION PLAT Ft. from N. Line990 Ft. from S. Line Ft. from E. Line990 Ft. from W. Line

		0	

Butler County

Location Rig up

Drilling and Remarks:

CR 423745" @ 2374Pump 100 ft38° SW

RECORD

Cased in., ft.Sand Gas Oil Total Depth 2412

PRODUCTION

1st 24 hrs. Nat. 1st 24 hrs. after shot Gas Cu. Ft.Dry Hole Abandoned

Date

JUL 23 1947 19S. J. LEWIS Scout