

Section 21 Township 25 Range 5EWell No. 139 ChesneyCompany Cities Service

Misc.		NORTH					
WEST							
						0	
		SOUTH					

0

KANSAS

Butler County ✓

Sec. 21 Twp. 25 R. 5-E

Well No. 139 Chesney Farm

Cities Service Company


Miscellaneous

330 Ft. from N. Line

Ft. from S. Line

990 Ft. from E. Line

Ft. from W. Line

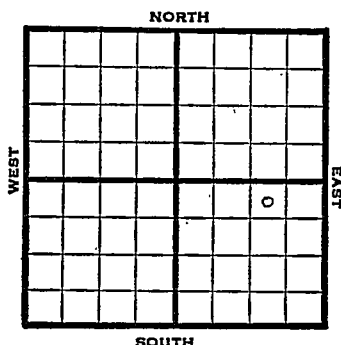

NW NE SE

1947 Elev. 1369: REPORT

7/30 8 " @ 45 WOC

8/6 Lansing 1621'
K. C. 1910'
Drlg 1950'

8/13 Arbuckle 2355
TD 2359'
5" @ 2356'

8/20 "

8/27 "

9/3 TD 2430'
Pump 30 bbls oil 15 hrs.

9/10 "

9/17 Arbuckle 2355'
5" @ 2356'
Pump 50 Pot
Gr. 38°
Total Depth 2430'

COMPLETED

Map No. _____ Sec. 21 Twp. 25 R. 5E

Well No. 139 Chesney

Cities Service Company

FIRST REPORT

Contractor

NW NE SE

SECTION PLAT

330 Ft. from N. Line

_____ Ft. from S. Line

990 Ft. from E. Line

_____ Ft. from W. Line

			o

Butler County

Location _____

Rig up _____

Drilling and Remarks:

8" @ 45 WOC

RECORD

Cased _____ in., _____ ft.

Sand _____

Gas _____

Oil _____

Total Depth _____

PRODUCTION

1st 24 hrs. Nat. _____

1st 24 hrs. after shot _____

Gas _____ Cu. Ft.

Dry Hole _____

Abandoned _____

Date

JUL 30 1947

19

S. J. LEWIS

Scout

Map No. 14 Sec. 21 Twp. 25 R. 5E

Well No. 139 Chesney

Cities Service Company

COMPLETE Contractor

NW NE SE

211,1369

SECTION PLAT

330 Ft. from N. Line

 Ft. from S. Line

990 Ft. from E. Line

 Ft. from W. Line

			6

Butler County

Location

Rig up

Drilling and Remarks:

Ar 42955

5" @ 2856

Pump 500 ft

2856

RECORD

Cased in., ft.

Sand

Gas

Oil

Total Depth 2430

PRODUCTION

1st 24 hrs. Nat.

1st 24 hrs. after shot

Gas Cu. Ft.

Dry Hole

Abandoned

Date

SEP 17 1947 19

S. J. LEWIS

Scout