

KANSAS Barton

Section 7 Township 17 Range 14-W

Well No. #1 Schmidt

Company Derby Oil

NORTH

WEST

0							

EAST

SOUTH

5

Barton

KANSAS

Sec. 7 Twp. 17 R. 14W

Well No. #1 Schmidt Farm

Derby Oil, Company

Peel Drlg. Contr. Contractor

Leoville Pool


 Ft. from N. Line

990' Ft. from S. Line

 Ft. from E. Line

330' Ft. from W. Line


NW SW NW

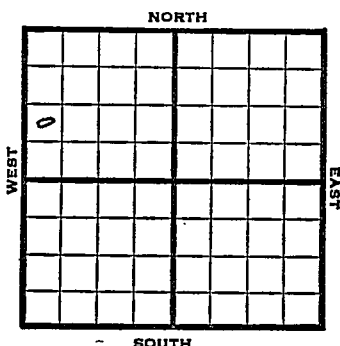

1950 Elev. 1962 REPORT

11/15 Spud 11-12-50
8-5/8" @ 600'
Drlg. 1170'

12/6 Spud 11-12-50
D&A TD 3484
8-5/8" @ 600' Heeb. 3145
KC 3210' Cong. 3442
Arb. 3463-65 4 1/2" @ 3464
TD 3484 S/1 -3/4 boph PB 3329
36/3242-54 D&A
ABANDONED

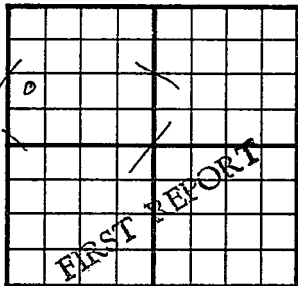County Barton State KansasSec. 7 (Blk. Twp.) 17 (Sur. Rge.) 14W Map No.Operator Derby OilWell No. 1 Farm SchmidtElev. Location NW SW NW990 Ft. From S Line NW330 Ft. From W Line QuarterIst. Report NOV 15 1950


Completion

Remarks

Peel Drig. - Contr.Spudding Date 11-12-50Drlg. Data Leoville Pool8 5/8" @ 600 drlg. 1170

J. E. TYRA

County Barton State Kansas
 Sec. 7 (Blk. 17 (Sur. 14W Map No.
 (Twp. (Rge.
 Operator Derby Oil
 Well No. 1 Farm Schmidt
 Elev. 1962 Location NW SW NW

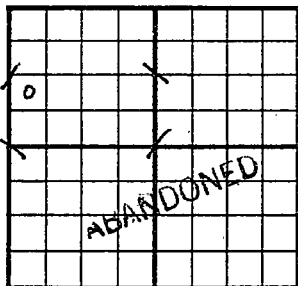

990 Ft. From S Line NW
330 Ft. From W Line Quarter
 Ist. Report
 Completion DEC 6 1950
 Remarks Leoville Pool
Peel Drlg. - Contr.
 Spudding Date 11-12-50

Drlg. Data D & A TD 3484
8 5/8" @ 600 Heeb. 3145 KC 3210
Cong. 3442 Arb. 3463-65 4 1/2" @ 3464
TD 3484 S/ 1 3/4 boph PB 3329
36/ 3242-54 D & A

J. E. TYRA