

FORM 51 IOM 12-46 PETROL

FORM 51 IOM 12-46 PETROL

Section 21 Township 25 Range 5-E

Well No. 142 Chesney

[illegible]

Miscellaneous NORTH

WEST

EAST

SOUTH

0

KANSAS

Butler

Sec. 21 Twp. 25 R. 5E

Well No. #142 Chesney Farm

Cities Service Company

Misc.


 Ft. from N. Line

990 Ft. from S. Line

990 Ft. from E. Line

 Ft. from W. Line

NW SE NE

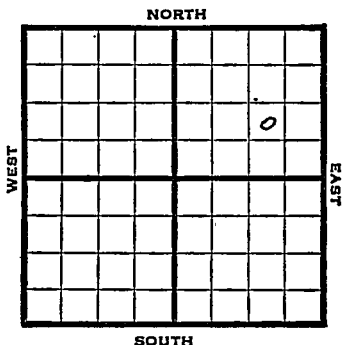

1947 Elev. 1349' REPORT

9/24 Location

10/1 Drlg. 260'

10/8 Lansing 1621'
KC 1921'

10/15 Drlg. 2150'
Drlg. 2180'

10/22 Arbuckle 2413'
5" @ 2414'
Pump 67 Pot
Total Depth 2443'
Gr. 380

COMPLETED

Map No. _____ Sec. 21 Twp. 25 R. 5E

Well No. 142 Chesney

_____ Cities Service _____ Company

FIRST REPORT

_____ Contractor

NW SE NE


SECTION PLAT

_____ Ft. from N. Line

990 Ft. from S. Line

990 Ft. from E. Line

_____ Ft. from W. Line

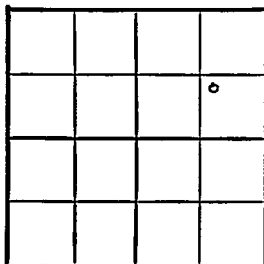

_____ Butler County

Location X

Rig up _____

Drilling and Remarks:

RECORD

Cased _____ in., _____ ft.

Sand _____

Gas _____

Oil _____

Total Depth _____

PRODUCTION

1st 24 hrs. Nat. _____

1st 24 hrs. after shot _____

Gas _____ Cu. Ft.

Dry Hole _____

Abandoned _____

Date

SEP 24 1947 19

S. J. LEWIS Scout

Kansas

Miscellaneous

Map No. 14 Sec. 21 Twp. 25 R. 5EWell No. 142 Chesney

Cities Service

Company

COMPLETE

Contractor

NW SE NE

E1, 1849

SECTION PLAT

			0

_____ Ft. from N. Line

990 Ft. from S. Line990 Ft. from E. Line

_____ Ft. from W. Line

Butler County

Location _____

Rig up _____

Drilling and Remarks:

*CR 2418**5" C 2414**Pump 67028**38° 34'*

RECORD

Cased _____ in., _____ ft.

Sand _____

Gas _____

Oil _____

Total Depth 2440

r PRODUCTION

1st 24 hrs: Nat. _____

1st 24 hrs. after shot _____

Gas _____ Cu. Ft.

Dry Hole _____

Abandoned _____

Date

OCT 22 1947 19 S. J. LEWIS Scout