

KANSAS

Butler


Section 21 Township 25 Range 5EWell No. 143 ChesneyCompany Cities Service

Misc.

NORTH

WEST

EAST

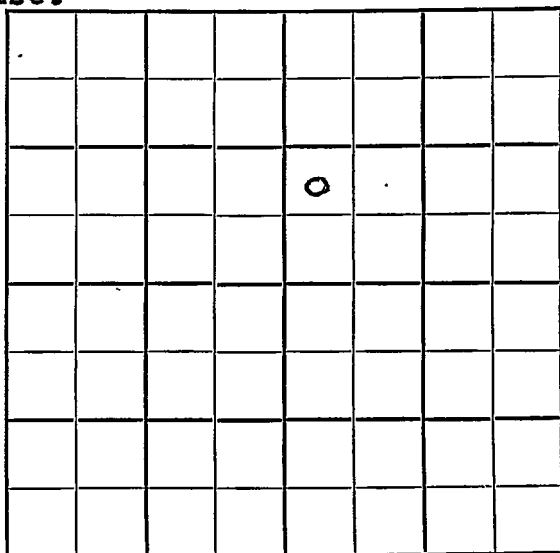

SOUTH

Sec. 21 Twp. 25 R. 5E

Well No. 143 Chesney Farm

Cities Service Company
Misc.

 Ft. from N. Line

990


 Ft. from S. Line

 Ft. from E. Line

330

 Ft. from W. Line

NW SW NE

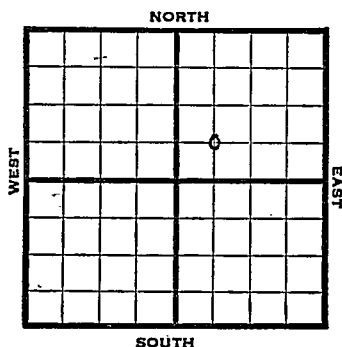

1947 Elev. 1351' REPORT

10/22 Douglas 1441
1770'

11/5 Arbuckle 2371'
5" @ 2379'
Pump 120 Pot
380 Gr.
Total Depth 2402'

COMPLETED

Map No. _____ Sec. 21 Twp. 25 R. 5E

Well No. 143 Chesney

Cities Service _____ Company _____

FIRST REPORT _____ Contractor _____

NW SW NE


SECTION PLAT

_____ Ft. from N. Line

990 _____ Ft. from S. Line

_____ Ft. from E. Line

330 _____ Ft. from W. Line

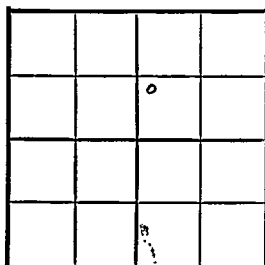

Butler County

Location _____

Rig up _____

Drilling and Remarks:

Douglas 1441

1770

RECORD

Cased _____ in., _____ ft.

Sand _____

Gas _____

Oil _____

Total Depth _____

PRODUCTION

1st 24 hrs. Nat. _____

1st 24 hrs. after shot _____

Gas _____ Cu. Ft.

Dry Hole _____

Abandoned _____

Date

OCT 22 1947 19 _____ S. J. LEWIS _____ Scout

Kansas

Map No. 14 Sec. 21 Twp. 25 R. 5EWell No. 143 Chesney

Cities Service Company

COMPLETE Contractor

NW SW NE

E1.1351
SECTION PLAT Ft. from N. Line990 Ft. from S. Line Ft. from E. Line330 Ft. from W. Line

		△	

Butler County

Location Rig up

Drilling and Remarks:

*Per 82871**5' @ 2375**Pump 120 12/2**85° Lu*

RECORD

Cased in, ft.Sand Gas Oil Total Depth 2402

PRODUCTION

1st 24 hrs. Nat. 1st 24 hrs. after shot Gas Cu. Ft.Dry Hole Abandoned

Date

NOV 5 1947 19

S. J. LEWIS Scout