


Section 21 Township 25 Range 5EWell No. #144 ChesneyCompany Cities Service

Miscellaneous

NORTH

WEST

EAST

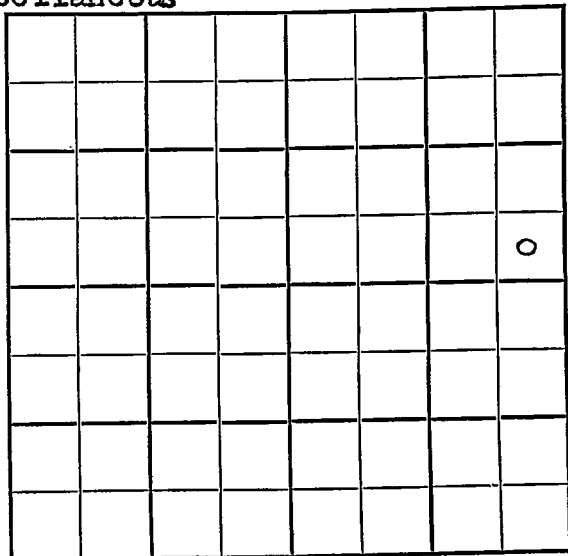

SOUTH

KANSAS

Butler

Sec. 21 Twp. 25 R. 5EWell No. #144 Chesney Farm _____
Cities Service Company _____

_____ Ft. from N. Line

330


_____ Ft. from S. Line

330

_____ Ft. from E. Line

_____ Ft. from W. Line

SE NE

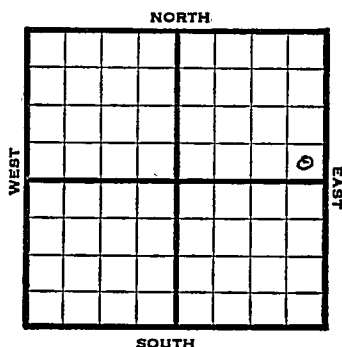

1947 Elev. 1367' REPORT

10/29 RUR

11/5 Lansing 1636'
KC 1928'
Sd 2199'
Drlg. 2220'11/12 Arbuckle 2429'
TD 2432'
5" @ 2430'
RUST

11/19 TD 2454'

11/25 "

12/3 Arbuckle 2429'
5" @ 2430'
Pump 55 Pot
Gr. 380
Total Depth 2454'**COMPLETED**

Map No. _____ Sec. 21 Twp. 25 R. 5E

Well No. 144 Chesney

Cities Service

Company

FIRST REPORT

Contractor

SE NE

SECTION PLAT

_____ Ft. from N. Line

330 Ft. from S. Line

330 Ft. from E. Line

_____ Ft. from W. Line

Butler County

Location _____

Rig up _____

Drilling and Remarks:

R U R

RECORD

Cased _____ in., _____ ft.

Sand _____

Gas _____

Oil _____

Total Depth _____

PRODUCTION

1st 24 hrs. Nat. _____

1st 24 hrs. after shot _____

Gas _____ Cu. Ft.

Dry Hole _____

Abandoned _____

Date

OCT 29 1947

S. J. LEWIS Scout

Form 26 200 Bks. 10-46 Petrol
KansasMap No. 14 Sec. 21 Twp. 25 R. 5EWell No. 144 Chesney

Cities Service

Company


COMPLETE

Contractor

SE NE

E11367

SECTION PLAT

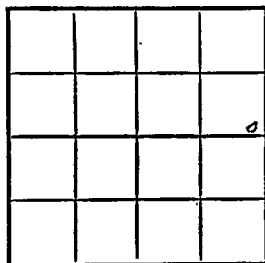 Ft. from N. Line330 Ft. from S. Line330 Ft. from E. Line Ft. from W. Line

Butler County

Location Rig up

Drilling and Remarks:

CR 824295' @ 2430 88-34

RECORD

Cased in., ft.Sand Gas Oil Total Depth 2454

PRODUCTION

1st 24 hrs. Nat. 1st 24 hrs. after shot Gas Cu. Ft.Dry Hole Abandoned

Date

DEC 3 1947 19S. J. LEWIS Scout