

Section 7 Township 17 Range 11WWell No. #5 SchmidtCompany John Lindas

NORTH

	0							

SOUTH

4

WEST

EAST

Barton

KANSAS

SEC.	TWP.	R.
7	17	14W ✓

WELL NO.

#5 Schmidt

FARM

COMPANY

John Lindas

CONTRACTOR

Lindas

Leoville Pool

990

Ft. from N. Line


Ft. from S. Line

Ft. from E. Line

990

Ft. from W. Line

SE NW NW

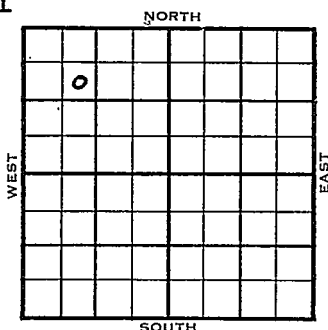

	ELEVATION	REPORT
1953	1964'	
9/23	RUR	
9/30	Anhy 952'	
	8" @ 958'	
	Drlg 3304'	
10/7	Heeb 3145'	KC 3231' Arb. 3460'
	RTD 3466	5" @ 3461 CO 3466
	50 A 1 1/4 BFPH	60% wtr.
	S/23 GO & 33 GW	1 hr.
10/14	NR	
10/21	P/17 BO	10 hrs. 60% wtr.
10/28	P/40 BO + 125 BW	24 hrs.
11/4	NR	
11/11	"	
11/18	"	
12/22	Spud 9-21-53	
	Oil Well	
	TD 3466'	
	Anhy 952'	
	8" @ 958'	
	Heeb 3145'	KC 3231', Arb. 3460'
	TD 3466'	
	5" @ 3461'	
	CO to 3466	50A

(Information Brought Forward)

1953

12/22 $1\frac{1}{4}$ bfph 60% wtr.
S/23 go 33 gw 1 hr.
P/17 bo 10 hrs., 60% wtr.
P/40 bo 125 bw 24 hrs.
Comp. 84 bopd 32% wtr.

COMPLETED

County Barton State Kansas
 Sec. 7 (Blk. 17) (Sur. 14W) Map No. 17
 Operator John Lindas
 Well No. 5 Farm Schmidt
 Elev. SE NW NW Location

990 Ft. From N Line NW

990 Ft. From W Line Quarter

1st. Report SEP 23 1953

Completion

Remarks

Lindas - Contr.

Spudding Date

Drig. Data

Leoville Pool

R U R

J. G. McGEHEE

County Barton State KansasSec. 7 (Blk. 17 (Sur. 14W (Twp. Map No. Rge.)Operator John LindasWell No. 5 Farm SchmidtElev. 1964 Location SE NW NW

990 Ft. From N Line NW990 Ft. From W Line Quarter1st. ReportCompletion DEC 22 1953Remarks Leoville PoolLindas - Contr.Spudding Date 9-21-53Drlg. Data Oil well TD 3466Anhy 952 8" @ 958 Heeb. 3145KC 3231 Arb. 3460 TD 3466 5" @ 3461CO to 3466 50 A $1\frac{1}{4}$ bfph 60% wtr.S/ 23 go 33 gw 1 hr. P/ 17 bo 10 hr.60% wtr. P/ 40 bo 125 bw 24 hr.Comp. 84 bopd 32% wtr.

J. G. McGEHEE