
FORM 51 25M 8-50 WESTERN

Barton KANSAS

Section 8 Township 17 Range 14W

Well No. #1 Borchers

Company Lindas Oil

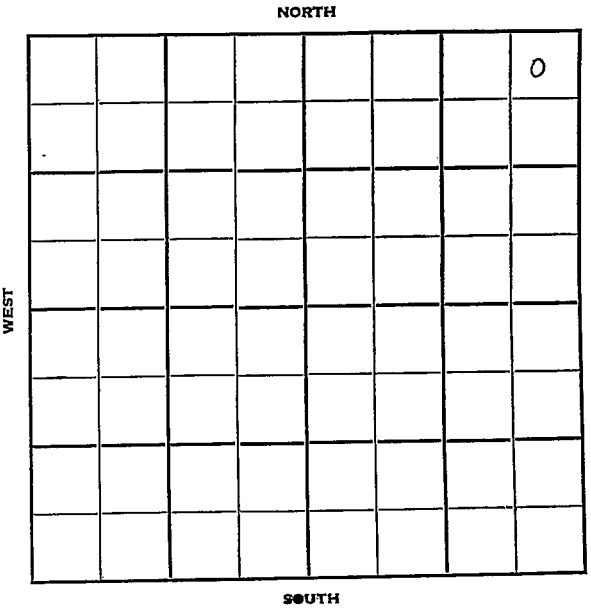

FORM 252-B
10M 10-50 PETROL

Barton KANSAS

Sec. 8 Twp. 17 R. 14W

Well No. #1 Borchers Farm

Lindas Oil Company

Contractor


330' Ft. from N. Line

Ft. from S. Line

330' Ft. from E. Line

Ft. from W. Line

NE NE NE

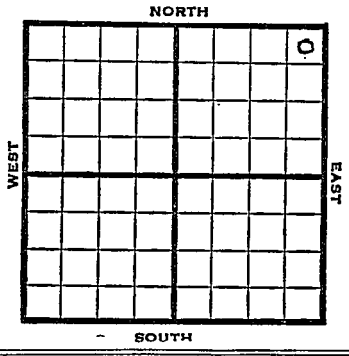

1950	Elev 1996' REPORT
12/20	Spud 12-13-50 8-5/8" @ 188' Anhy 995' Drlg. 2328'
12/27	Spud 12-13-50 D&A TD 3556 8-5/8" @ 188 Anhy 995' Top. 2943 Heeb. 3178 Toronto 3190 Lans. 3244' Sh. Cong. 3469 Ch. Cong. 3488 Simp. 3540 Arb. 3542-53 TD 3556' D&A ABANDONED

FORM 275 FOR SALE BY KANSAS BLUE PRINT CO.


County Barton State Kansas

Sec. 8 (Blk. Twp.) 17 (Sur. Rge.) 14W Map No.

Operator Lindas Oil

Well No. 1 Farm Borchers

Elev. Location NE NE NE

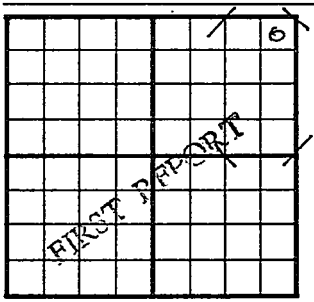

330 Ft. From N Line NE

330 Ft. From E Line Quarter

1st. Report DEC 20 1950

Completion

Remarks Stanolind DHM

Spudding Date 12-13-50

Drlg. Data

8 5/8" @ 188 Anhy 995 drlg. 2328

J. E. TYRA

FORM 275 FOR SALE BY KANSAS BLUE PRINT CO.


County Barton State Kansas

Sec. 8 (Blk. Twp.) 17 (Sur. Rge.) 14W Map No.

Operator Lindas Oil

Well No. 1 Farm Borchers

Elev. 1996 Location NE NE NE

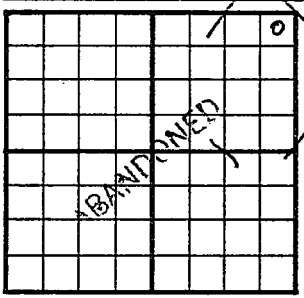

330 Ft. From N Line NE

330 Ft. From E Line Quarter

1st. Report

Completion DEC 27 1950

Remarks

Spudding Date 12-13-50

Drlg. Data D & A TD 3556

8 5/8" C 188 Anhy 995 Top. 2943

Heeb. 3178 Toronto 3190 Lans. 3244

Sh. Cong. 3469 Ch. Cong. 3488

Simp. 3540 Arb. 3542-53 TD 3556

D & A

J. E. TYRA