


Section 8 Township 17 Range 11W

Well No. #1 Borchers

Company Royal Oil & Braden Drlg.

NORTH

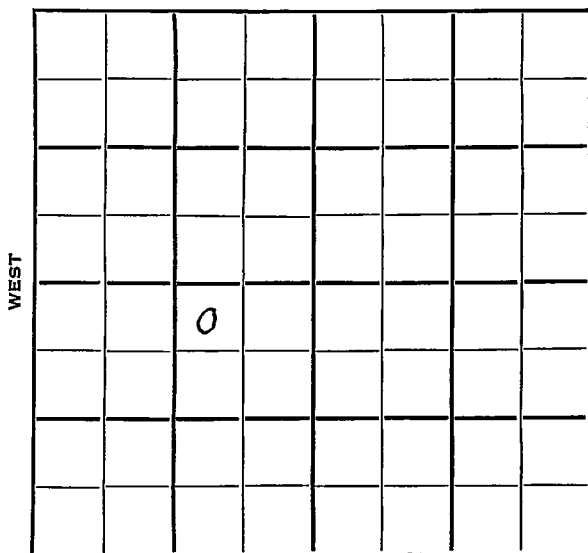

SOUTH

Barton

FORM 252-B

KANSAS

Sec. 8 Twp. 17 R. 11W

Well No. #1 Borchers Farm

Royal Oil & Braden Drlg. Company

Braden Drlg. Contractor

Leoville Pool


330 Ft. from N. Line

\_\_\_\_\_ Ft. from S. Line

990 Ft. from E. Line

\_\_\_\_\_ Ft. from W. Line

NW NE SW

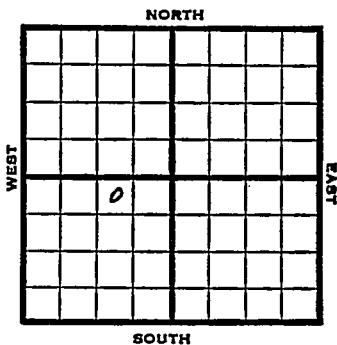

1953

Elev. 1916' REPORT

8/19

M I R

8/26

8" @ 584 w/300  
Drlg. 2060'

9/2

Heeb. 3104, Tor 3120, L<sup>u</sup>ans 3172  
D & A

9/9

Spud 8-19-53  
D&A  
TD 3460  
8" @ 584  
Heeb 3104, Tor 3120, L<sup>u</sup>ans 3172,  
B KC 3389, Cong 3405  
TD 3460  
D&A

**ABANDONED**

County Barton State Kansas

Sec. 8 (Blk. Twp.) 17 (Sur. Rge.) 14W Map No.

Operator Royal Oil & Braden Drlg.

Well No. 1 Farm Borchers

Elev. \_\_\_\_\_ Location NW NE SW

FIRST REPORT					

330 Ft. From N Line SW

990 Ft. From E Line Quarter

Ist. Report AUG 19 1953

Completion \_\_\_\_\_

Remarks \_\_\_\_\_

Braden Drlg. - Contr.

Spudding Date \_\_\_\_\_

Drig. Data Leoville Pool

M I R

