DX 78-1

Barton KANSAS

Section 8 Township 17 Range 14 W

Well No. # 2 Borchers

Company ~~Braden Drlg.~~

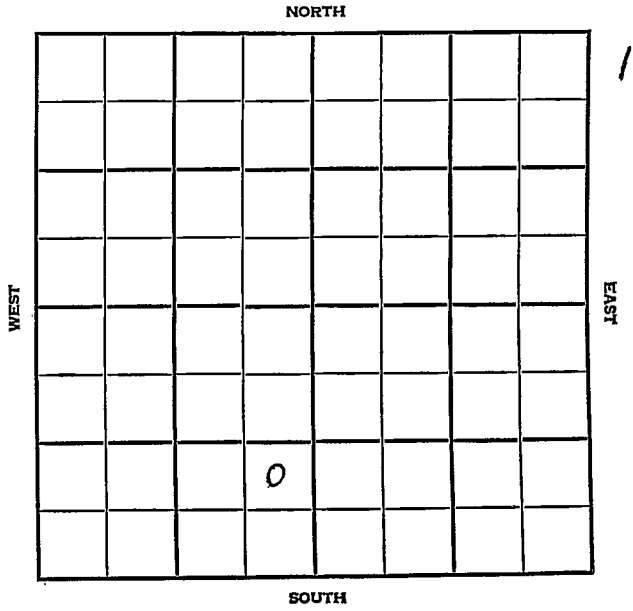

14

Barton KANSAS

SEC.	TWP.	R.
8	17	14 W

WELL NO.

2 Borchers FARM

COMPANY

Braden Drlg.

CONTRACTOR

Co. tools

_____ Ft. from N. Line

990 Ft. from S. Line

330 Ft. from E. Line

_____ Ft. from W. Line

NE SE SW

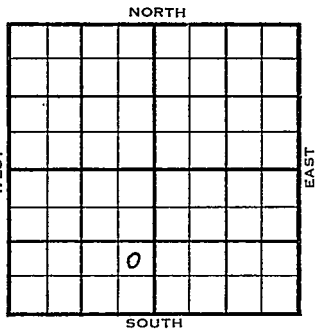

1954	ELEVATION 1944' REPORT
10/27	Spud 10-21-54 8" @ 590 SD
11/23	Spud 10-21-54 D & A TD 3457' 8" @ 590' Heeb 3118', Tor 3134', Br. Lime 3184' Lans 3197', Arb. 3437' TD 3457' 5" @ 3440' CO to 3457 S/ 1 boph 250 A S/ 2 boph 500 A S/ 2½ boph dec. to ½ boph D & A **ABANDONED**

DX-78

FORM 275 FOR SALE BY KANSAS BLUE PRINT CO.

County Barton State Kansas

Sec. 8 (Blk. Twp.) 17 (Sur. Rge.) 14W Map No.

Operator Braden Drlg.

Well No. 2 Farm Borchers

Elev. Location NE SE SW

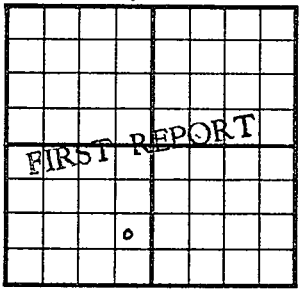

990 Ft. From S Line SW

330 Ft. From E Line Quarter

1st. Report OCT 27 1954

Completion

Remarks

Co. tools

Spudding Date 10-21-54

Drlg. Data

8" @ 590 SD

FABEN GILSTRAP

FORM 275 FOR SALE BY KANSAS BLUE PRINT CO.

County Barton State Kansas

Sec. 8 (Blk. Twp.) 17 (Sur. Rge.) 14W Map No.

Operator Braden Drlg.

Well No. 2 Farm Borchers

Elev. 1944 Location NE SE SW

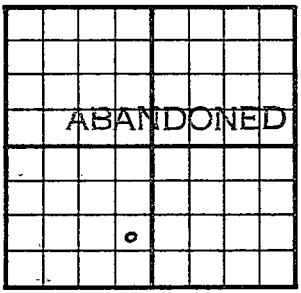

990 Ft. From S Line SW

330 Ft. From E Line Quarter

1st. Report

Completion NOV 23 1954

Remarks

Co. tools

Spudding Date 10-21-54

Drlg. Data D & A TD 3457

8" @ 590 Heeb. 3118 Tor. 3134

Br. lime 3184 Lans. 3197 Arb. 3437

TD 3457 5" @ 3440 CO to 3457

S/ 1 boph 250 A S/ 2 boph 500 A

S/ 2½ boph dec. to ½ boph

D & A

FABEN CUST