
FORM 51 25M 3-49 PETROL Barton KANSAS

Section 9 Township 17 Range 14 W

Well No. # 2 Dietz

Company Lewis Drlg.

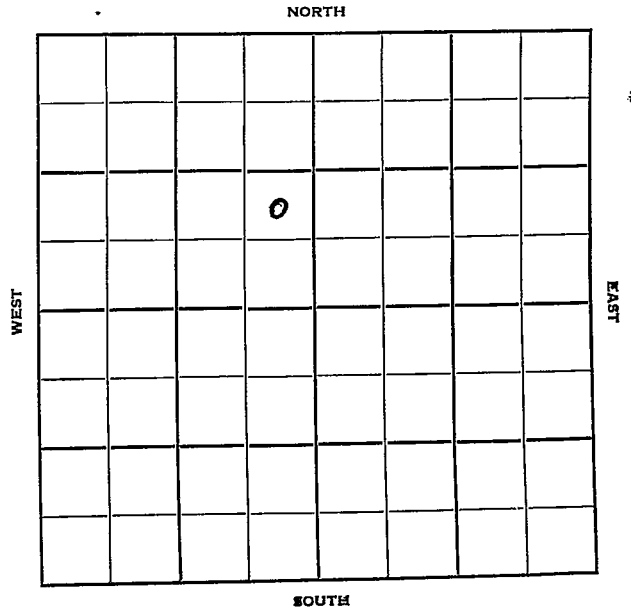

6

FORM 252-B
10M 8-51 TPCO.

Barton KANSAS

Sec. 9 Twp. 17 R. 14W

Well No. #2 Dietz Farm

Lewis Drlg. Company

Lewis Drlg. - Contr. Contractor

Wildcat


Ft. from N. Line

990' Ft. from S. Line

330' Ft. from E. Line

Ft. from W. Line

NE SE NW

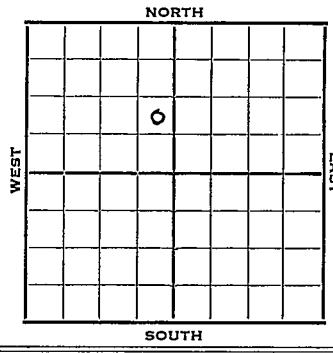

1952	Elev. 1958' REPORT
4/23	Spud 4-18-52 8" @ 607 Drlg. 2325'
4/30	Lans. 3197 DST 3197-3215, 1 hr. 520' wtr. 820# DST 3217-28, 1 hr. 260' oil 90' wtr. 911# DST 3288-3305, 1 hr. 97' SW 1084# Cong. 3426 Drlg. 3511'
5/7	Spud 4-18-52 D & A TD 3516' 8" @ 607 Lans. 3197' DST 3197-3215 open 1 hr, rec 520' water. DST 3217-28 open 1 hr, rec 260' oil, 90' water. DST 3288-3305 open 1 hr, rec 97' SW Cong. 3426' TD 3516' D & A

ABANDONED

FORM 275 FOR SALE BY KANSAS BLUE PRINT CO.


County Barton State Kansas

Sec. 9 (Blk. Twp.) 17 (Sur. Rge.) 14W Map No.

Operator Lewis Drlg.

Well No. 2 Farm Dietz

Elev. 1958 Location NE SE NW

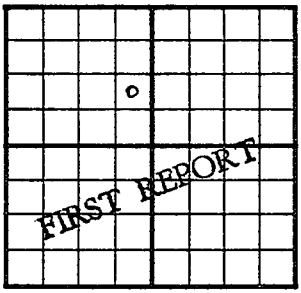

990 Ft. From S Line NW

330 Ft. From E Line Quarter

1st. Report APR 23 1952

Completion

Remarks Skelly - $3500

Lewis Drlg. - Contr.

Spudding Date 4-18-52

Drlg. Data Wildcat

8" @ 607 drlg. 2325

J. G. McGEHEE

FORM 275 FOR SALE BY KANSAS BLUE PRINT CO.


County Barton State Kansas

Sec. 9 (Blk. Twp.) 17 (Sur. Rge.) 14W Map No.

Operator Lewis Drlg.

Well No. 2 Farm Dietz

Elev. 1958 Location NE SE NW

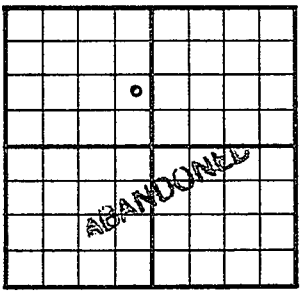

990 Ft. From S Line NW

330 Ft. From E Line Quarter

1st. Report

Completion MAY 7 1952

Remarks Wildcat

Lewis Drlg. - Contr.

Spudding Date 4-18-52

Drlg. Data D & A TD 3516

8" @ 607 Lans. 3197 DST 3197-3215

open 1 hr. Rec. 520' water DST 3217-28

open 1 hr. Rec. 260' oil 90' water

DST 3288-3305 open 1 hr. Rec. 97' sw

Cong. 3426 TD 3516

D & A

J. G. McGEHEE