


Barton KANSAS

DX 78-1

Section 8 Township 17 Range 11W

Well No. #2 Borchers "A"

Company Birmingham & Bartlett

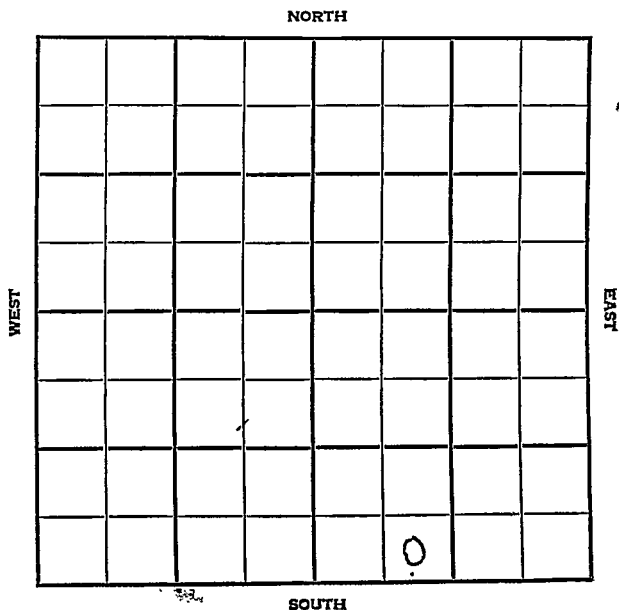

Barton

KANSAS

|      |      |      |
|------|------|------|
| SEC. | TWP. | R.   |
| 8    | 17   | 14 W |

WELL NO.

# 2 Borchers "A"

FARM

COMPANY

Birmingham &amp; Bartlett

CONTRACTOR

Co. tools

N. Carroll Pool

Ft. from N. Line

330

Ft. from S. Line


330

Ft. from E. Line

990

Ft. from W. Line

SWSE  
SE SE SW

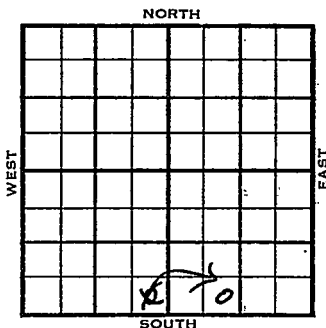

1955

ELEVATION

1965'

REPORT

3/30

Spud 3-28-55  
8" @ 609 WOC

4/13

Spud 3-28-55 Oil well TD 3462  
8" @ 609 Anhy 964 Heeb 3133  
Br. line 3198 Lans 3210 Cong 3430  
Arb. 3454 TD 3457 5" @ 3456  
DD 3462 FU 750' oil B/7 BO 5 hr.  
Comp. 30 BOPD

**COMPLETED**

FABEN GILSTRAP

## SCOUT TICKET

DX-201

Kansas

SEC.

8

TWP.

17

R.

14W

WELL NO.

2 Borchers "A"

FARM

COMPANY

Birmingham &amp; Bartlett

CONTRACTOR

CORRECTION

SE SW SE

NORTH

\_\_\_\_ FT. FROM N. LINE

330

\_\_\_\_ FT. FROM S. LINE

\_\_\_\_ FT. FORM E: LINE

990

\_\_\_\_ FT. FROM W. LINE

|       |  |  |  |  |  |  |  |   |  |      |
|-------|--|--|--|--|--|--|--|---|--|------|
| WEST  |  |  |  |  |  |  |  |   |  | EAST |
|       |  |  |  |  |  |  |  |   |  |      |
|       |  |  |  |  |  |  |  |   |  |      |
|       |  |  |  |  |  |  |  | 0 |  |      |
| SOUTH |  |  |  |  |  |  |  |   |  |      |

Barton County

☐

LOCATION

☐

RIG UP

DRILLING AND-REMARKS:

Reported

SE SE SW

Correct  
the spot B

RECORD

CASED IN.. FT.

SAND

GAS

OIL

TOTAL DEPTH

1ST 24 HRS. NAT.

1ST 24 HRS. AFTER SHOT

GAS CU. FT.

DRY HOLE

ABANDONED


PRODUCTION

DATE

MAR 30 1955

SCOUT

FARM ON STRAP

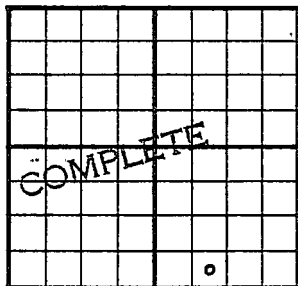County Barton State KansasSec. 8 (Blk.) 17 (Sur.) 14 W Map No.Operator Birmingham & BartlettWell No. 2 Farm Borchers "A"Elev. 1965 Location SE SW SE330 Ft. From S Line SE990 Ft. From W Line Quarter

1st. Report

Completion APR 13 1955Remarks N. Carroll PoolCo. toolsSpudding Date 3-28-55Drilg. Data Oil well TD 34628" @ 609 Anhy 964 Heeb. 3133Br. lime 3198 Lans. 3210 Cong. 3430Arb. 3454 TD 3457 5" @ 3456DD 3462 FU 750' oil B/ 7 bo 5 hr.Comp. 30 bopd

FABEN GILSTRAP