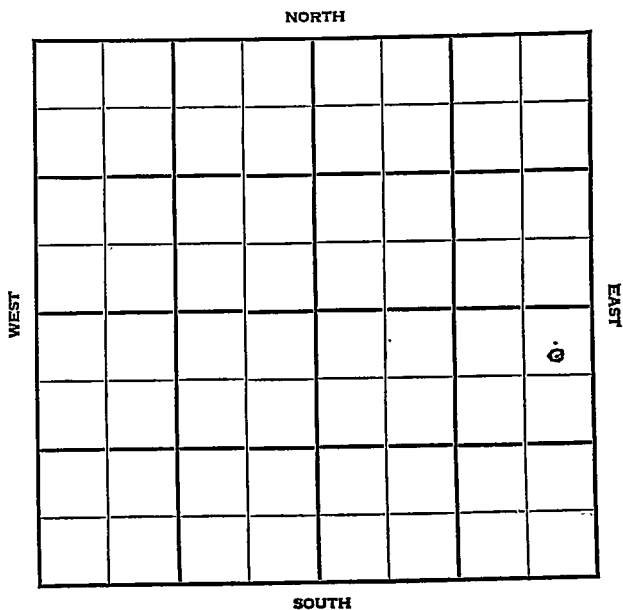


KANSAS

Butler

Section 21 Township 25 Range 5EWell No. #149 ChesneyCompany Cities Service

Sec. 21 Twp. KANSAS 25 R. 5E

Well No. #149 Chesney Farm

Cities Service Company


Misc.

330 Ft. from N. Line

 Ft. from S. Line

360 Ft. from E. Line

 Ft. from W. Line

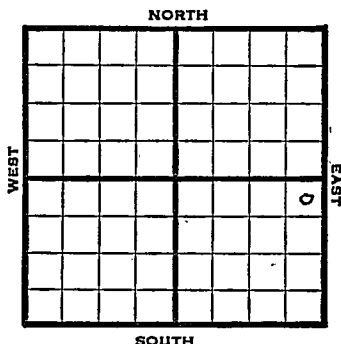

NE SE

1948 Elev. 1371' REPORT

1/14 8" @ 81'

1/21 Drlg. 2080'

1/26 Lansing 1633'
KC 1925'
Warmatan 2163'-66'
TD 2166'
5"@2162'

2/4 "

2/11 Drlg. 2188'

2/18 Marm 2163'
5" @ 21628
80 qts. 2172-2210'
Pump 50 Pot
38.0 Gr.
TD 2212'
Comp.

COMPLETED

Map No. _____ Sec. 21 Twp. 25 R. 5E

Well No. 149 Chesney

_____ Cities Service _____ Company

FIRST REPORT

_____ Contractor

NE SE

SECTION PLAT

380 Ft. from N. Line

_____ Ft. from S. Line

360 Ft. from E. Line

_____ Ft. from W. Line

			o

Butler County

Location _____

Rig up _____

Drilling and Remarks:

8" @ 81

RECORD

Cased _____ in., _____ ft.

Sand _____

Gas _____

Oil _____

Total Depth _____

PRODUCTION

1st 24 hrs. Nat. _____

1st 24 hrs. after shot _____

Gas _____ Cu. Ft.

Dry Hole _____

Abandoned _____

Date

JAN 14 1948 19

S. J. LEWIS

Scout

Map No. 14 Sec. 21 Twp. 25 R. 5E

Well No. 149 Chesney

Cities Service

Company

COMPLETE

Contractor

NE SE


E11271
SECTION PLAT

380 Ft. from N. Line

 Ft. from S. Line

360 Ft. from E. Line

 Ft. from W. Line

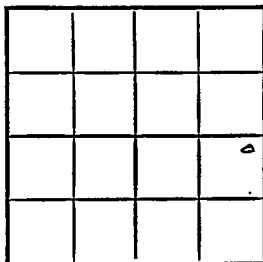

Butler County

Location

Rig up

Drilling and Remarks:

Marm 2162

5' @ 2162

50 ft 2172-2210

Pump 50 ft

625 ft

RECORD

Cased in., ft.

Sand

Gas

Oil ☒

Total Depth 2212

PRODUCTION

1st 24 hrs. Nat.

1st 24 hrs. after shot

Gas Cu. Ft.

Dry Hole

Abandoned

Date

FEB 18 1948

19

S. J. LEWIS

Scout