


Section 21 Township 25 Range 5E

Well No. #151 Chesney

Company Cities Service

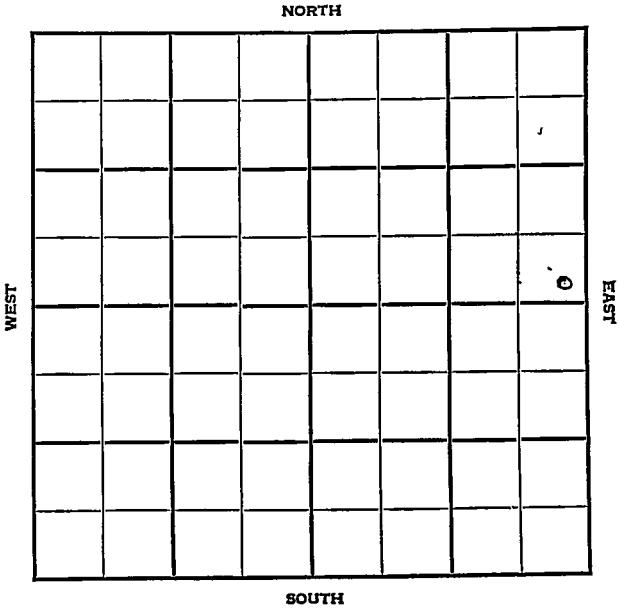

KANSAS

Butler


Sec. 21 Twp. 25 R. 5E ✓

Well No. #151 Chesney Farm

Cities Service Company

Miscellaneous

_____ Ft. from N. Line
270' Ft. from S. Line
320' Ft. from E. Line
 _____ Ft. from W. Line

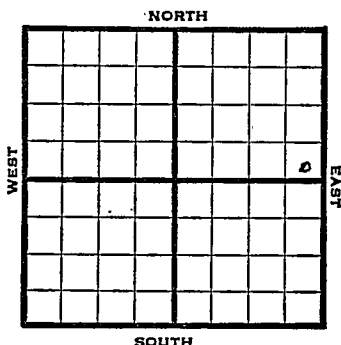

SE NE

1948 Elev. 1368' REPORT

- 2/4 8" @ 83'
WOC
 - 2/11 KC 1936'
Drlg. 2006'
 - 2/18 Marmatmon 2200'
TD 2203'
5" @ 2188'
RUST
 - 2/25 "
 - 3/3 TD 2215'
40 qts to 2199-2215 CO
 - 3/10 Swb 24 bbls oil
 - 3/17 "
 - 3/24 Marmstrom 2200'
5" @ 2188'
Pump 20 Pot.
TD 2215'
Gr. 38°
- COMPLETED**

Map No. _____ Sec. 21 Twp. 25 R. 5E

Well No. 151 Chesney

Cities Service Company

FIRST REPORT

Contractor

SE NE

SECTION PLAT

_____ Ft. from N. Line

270 Ft. from S. Line

320 Ft. from E. Line

_____ Ft. from W. Line

			o

Butler County

Location _____

Rig up _____

Drilling and Remarks:

8" @ 83 WOC
✓

RECORD

Cased - _____ in., _____ ft.

Sand _____

Gas _____

Oil _____

Total Depth _____

PRODUCTION

1st 24 hrs. Nat. _____

1st 24 hrs. after shot _____

Gas _____ Cu. Ft.

Dry Hole _____

Abandoned _____

Date

FEB 4 1948 19

S. J. LEWIS Scout

Form 26-200 Bks.-1-48-Palace
KansasMap No. 14 Sec. 21 Twp. 25 R. 5EWell No. 151 ChesneyCities Service CompanyCOMPLETE Contractor

SE NE

E. 1868
SECTION PLAT

			0
			1

 Ft. from N. Line270 Ft. from S. Line320 Ft. from E. Line Ft. from W. LineButler CountyLocation Rig up

Drilling and Remarks:

Marmaton 22005' 02 1/2"Pump 20' 1/2"38° SW

RECORD

Cased in., ft.Sand Gas Oil Total Depth 2215

-PRODUCTION

1st 24 hrs. Nat. 1st 24 hrs. after shot Gas Cu. Ft.Dry Hole Abandoned

Date

MAR 24 1948 19 S. J. LEWIS Scout