


McPherson KANSAS

DX 78-1

Section 7 Township 18 Range 1W

Well No. 1 C. R. Johnson

Company McCallard Drlg.

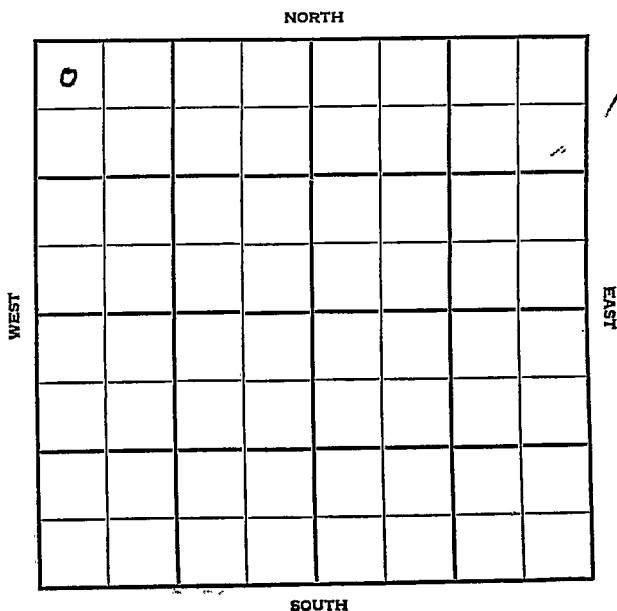


McPherson KANSAS

SEC. 7 TWP. 18 R. IW ✓

WELL NO. 1 C. R. Johnson FARM
COMPANY

CONTRACTOR Mallard Drlg.
Mallard Drlg.

330 Ft. from N. Line
Ft. from S. Line
Ft. from E. Line
330 Ft. from W. Line

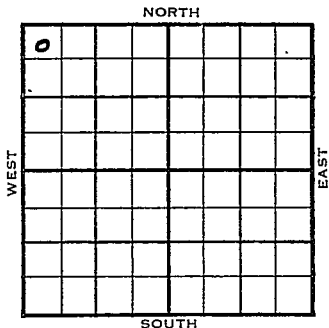

NW NW NW

Derby FO & DHM

| | ELEVATION | REPORT |
|------|-----------|--------|
| 1954 | 1470 | |

| | |
|------|--|
| 6/23 | Spdg 6-18-54 8" @ 138 Drlg. 2430 |
| 6/30 | Spud 6-18-54 8" @ 138' Miss 2856' TD 2866' D&A |

ABANDONED

County **McPherson** State **Kansas**

Sec. **7** (Blk.) **18** (Sur. Rge.) **1W** Map No.

Operator **Mallard Drlg.**

Well No. **1** Farm **C. R. Johnson**

Elev. **1470** Location **NW NW NW**

| | | | | | |
|---|--|--|--|--|--|
| o | | | | | |
| | | | | | |
| | | | | | |
| | | | | | |
| | | | | | |
| | | | | | |
| | | | | | |
| | | | | | |
| | | | | | |
| | | | | | |

330 Ft. From **N** Line **NW**

330 Ft. From **W** Line Quarter

1st. Report **JUN 23 1954**

Completion

Remarks **Derby farmout & DDM**

Mallard Drlg. - Contr.

Spudding Date **6-18-54**

Drlg. Data
8" @ 138 drlg. 2430

