

KANSAS

Butler

Section 21 Township 25 Range 5E

Well No. 153 Chesney[illegible]


KANSAS


Butler

Sec. 21 Twp. 25 R. 5EWell No. #153 Chesney FarmCities Service Company

Miscellaneous

345' Ft. from N. Line Ft. from S. Line1025' Ft. from E. Line Ft. from W. Line

NW NE SE

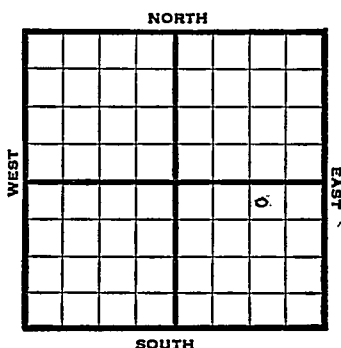

1948

Elev. 1370' REPORT

3/3 Location
3/10 Drlg. 1270'
3/17 Lansing 1520'
KC 1911'
BKC 2087'
Marmaton 2151'
TD 2162'
5" @ 2151'
3/24 TD 2190'
70 qts 2159-87 CO
3/31 Pump 10 bbls oil 2 hrs.
4/7 23 shots 1996-2001'
55 shots 1975-1988'
4/14 2000 Acid
4/21 KC 1911'
5" @ 2151'
2000 Acid
Pump 28 oil & 3 W Pot.
Gr. 38°
TD 2190'

COMPLETED

Map No. _____ Sec. 21 Twp. 25 R. 5E

Well No. 153 Chesney

Cities Service Company

-FIRST REPORT

Contractor

NW NE SE

SECTION PLAT

345 Ft. from N. Line

_____ Ft. from S. Line

1025 Ft. from E. Line

_____ Ft. from W. Line

			o

Butler County

Location X

Rig up _____

Drilling and Remarks:

RECORD

Cased _____ in., _____ ft.

Sand _____

Gas _____

Oil _____

Total Depth _____

PRODUCTION

1st 24 hrs. Nat. _____

1st 24 hrs. after shot _____

Gas _____ Cu. Ft.

Dry Hole _____

Abandoned _____

Date

MAR 3 1948 19 S. J. LEWIS Scout

Map No. 14 Sec. 21 Twp. 25 R. 5E

Well No. 153 Chesney

Cities Service Company

COMPLETE

Contractor

NW NE SE

E11370

SECTION PLAT

345 Ft. from N. Line

Ft. from S. Line

1025 Ft. from E. Line

Ft. from W. Line

			0

Butler County

Location

Rig up

Drilling and Remarks:

MC1911

5" C2151

2000 acid

Pump 2 Toil 7340

382

RECORD

Cased _____ in., _____ ft.

Sand _____

Gas _____

Oil ☒

Total Depth 2190

PRODUCTION

1st 24 hrs. Nat. _____

1st 24 hrs. after shot _____

Gas _____ Cu. Ft.

Dry Hole _____

Abandoned _____

Date

APR 21 1948

19

S. J. LEWIS

Scout