

Section 6 Township 17 Range 14 WWell No. # 1 JankeCompany Sunray

NORTH

WEST

EAST

SOUTH

14

0

Barton

KANSAS

Sec. 6 Twp. 17 R. 14W

Well No. #1 Janke Farm

Sunray Company

Stickle Drlg. - Contr. Contractor
Leoville Pool


 Ft. from N. Line

330' Ft. from S. Line

990' Ft. from E. Line

 Ft. from W. Line

SW SE SW

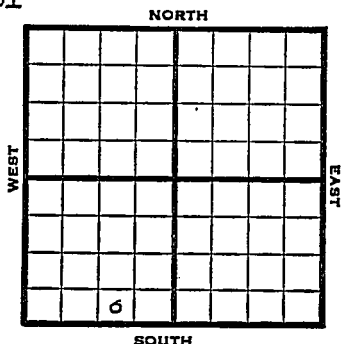

1951

Elev. 1942' REPORT

2/21

RUR

3/21

Spud 2-21-51

D&A TD 3464

8" @ 939

Anhy 930 Top. 2894

Heeb. 3128' Br Lime 3194

Lans. 3214 Cong. 3426

Arb. 3446'

DST 3447-50 opn 1 hr


Rec. 30' ocm 5" @ 3447

TD3452 SSO DD 3454

250 A S/7 gwph DD 3464

HFW D&A

ABANDONED

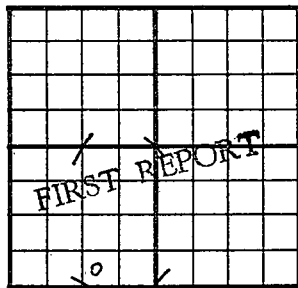County Barton State KansasSec. 6 (Blk. Twp.) 17 (Sur. Rge.) 14W Map No.Operator SunrayWell No. 1 Farm JankeElev. Location SW SE SW330 Ft. From S Line SW990 Ft. From E Line Quarter1st. Report FEB 21 1951

Completion

Remarks


Stickle Drlg. - Contr.

Spudding Date

Drlg. Data Leoville PoolR U R

J. E. TYRA

County Barton State Kansas
 Sec. 6 (Blk. 17 (Sur. 14W Map No.
 (Twp. (Rge.
 Operator Sunray
 Well No. 1 Farm Janke
 Elev. 1942 Location SW SE SW

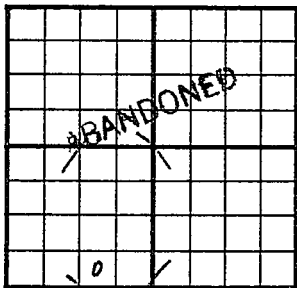

330 Ft. From S Line SW
990 Ft. From E Line Quarter

1st. Report

Completion MAR 21 1951

Remarks Leoville Pool
Stickle Drlg. - Contr.

Spudding Date 2-21-51

Drlg. Data D & A TD 3464

8" @ 939 Anhy 930 Top. 2994

Heeb. 3128 Br. lime 3194 Lans. 3214

Cong. 3426 Arb. 3446 DST 3447-50

open 1 hr. Rec. 30' ocm 5" @ 3447

TD 3452 SSO DD 3454 250 A

S/ 7 gwph DD 3464 HFW

D & A

J. E. TYRA