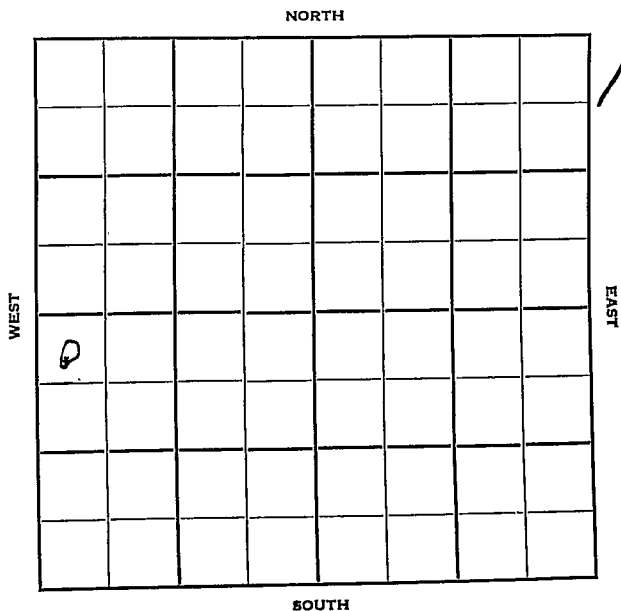


Section 6 Township 18 Range 1WWell No. #3 CrumpackerCompany Westgate-Greenland et al

McPherson KANSAS

Sec. 6 Twp. 18 R. 1W

Well No. #3 Crumpacker Farm

Westgate-Greenland et al Company

Mallard Drlg. Contractor


330' Ft. from N. Line

Ft. from S. Line

Ft. from E. Line

330' Ft. from W. Line

NW NW SW

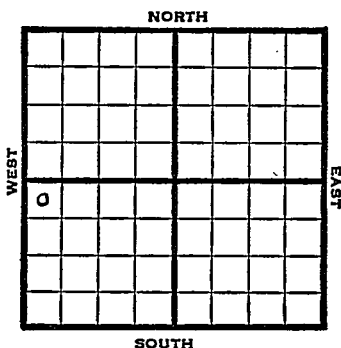

1950

Elev 1445

REPORT

6/14

Spud 6-9-50

10-3/4" @ 135'

Drlg. 1544'

8/2

10 3/4" @ 135'

Miss 2811-15'

7" @ 2812

TD 2817

1000 A

Comp 359 bopd 10% wtr


Completed

**COMPLETED**

~~Kansas~~Map No. \_\_\_\_\_ Sec. 6 Twp. 18 R. 1WWell No. 3 Crumpacker\_\_\_\_\_  
Westgate-Greenland etal. Company\_\_\_\_\_  
Mallard Drlg. Contractor

NW NW SW

## SECTION PLAT

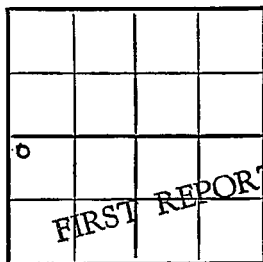330 Ft. from N. Line\_\_\_\_\_  
Ft. from S. Line\_\_\_\_\_  
Ft. from E. Line330 Ft. from W. Line

McPherson County

Location \_\_\_\_\_

Rig up \_\_\_\_\_

Drilling and Remarks:

Spud 6-9-50

10 3/4" @ 135

drlg. 1544

## RECORD

Cased \_\_\_\_\_ in., \_\_\_\_\_ ft.

Sand \_\_\_\_\_

Gas \_\_\_\_\_

Oil \_\_\_\_\_

Total Depth \_\_\_\_\_

## PRODUCTION

1st 24 hrs. Nat. \_\_\_\_\_

1st 24 hrs. after shot \_\_\_\_\_

Gas \_\_\_\_\_ Cu. Ft.

Dry Hole \_\_\_\_\_

Abandoned \_\_\_\_\_

Date

JUN 14 1950J. E. TYRA Scout

J. E. TYRA