

Barton

KANSAS

Section 6 Township 17 Range 14W

Well No. #1 Janke

Company N.C.R.A.

NORTH

WEST

EAST

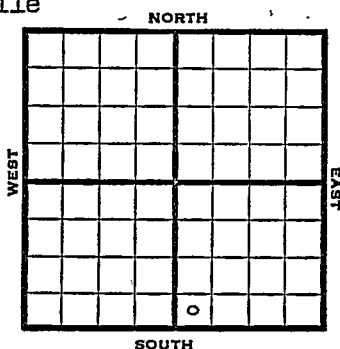
				0			

SOUTH

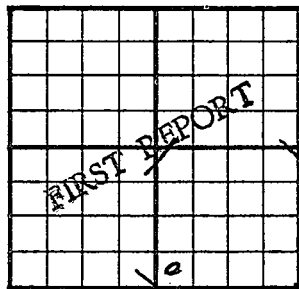
15

Sec. 6 Twp. 17 R. 14W ✓Well No. #1 Janke FarmN. C. R. A. CompanyFlornoy ContractorLeoville Ft. from N. Line330 Ft. from S. Line Ft. from E. Line330 Ft. from W. Line

SW SW SE



1951	Elev. 1953: REPORT
11/14	Spud 11-11-51 Drlg. 800'
11/28	Spud 11-11-51 D&A TD 3522 8" @947 Heeb. 3142 Br lime 3208 Lans. 3224 DST 3371-91 opn 45 min. Rec. 15'mud Cong. 3429 Arb. 3508 TD 3522 D&A
	ABANDONED

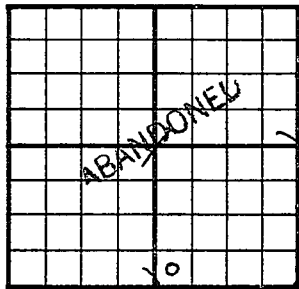
County Barton State KansasSec. 6 (Blk.) 17 (Sur.) 14W Map No.Operator N. C. R. A.Well No. 1 Farm JankeElev. 1953 Location SW SW SE330 Ft. From S Line SE330 Ft. From W Line QuarterIst. Report NOV 14 1951

Completion

Remarks

Florney - Contr.Spudding Date 11-11-51Drig. Data LeovilleDrig. 800

J. E. TYRA

County Barton State KansasSec. 6 (Blk. Twp.) 17 (Sur. Rge.) 14W Map No.Operator N C R AWell No. 1 Farm JankeElev. 1953 Location SW SW SE330 Ft. From S Line SE330 Ft. From W Line Quarter1st. ReportCompletion NOV 28 1951Remarks Leoville PoolFlorney - Contr.Spudding Date 11-11-51Drig. Data D & A TD 35228" @ 947 Heeb. 3142 Br. lime 3208Lans. 3224 DST 3371-91 open 45 min.Rec. 15' mud Cong. 3429 Arb. 3508TD 3522 D & A

J. E. TYRA