

Barton

KANSAS

Section 7 Township 17 Range 14W

Well No. #2 Curtis

Company Derby Drlg.

NORTH

WEST

EAST

SOUTH

Sec. 7 Twp. 17 R. 14W ✓

Well No. #2 Curtis Farm

Derby Drlg.

Company

Derby Drlg. - Contr.

Contractor

Wildcat

330'

Ft. from N. Line


Ft. from S. Line

Ft. from E. Line

330'

Ft. from W. Line

NW NW SE

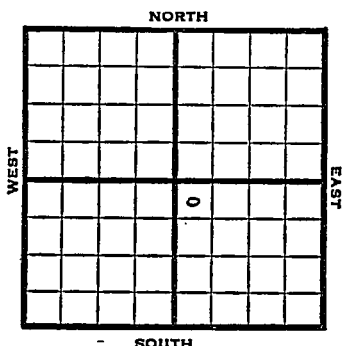

1950	Elev 1918'	REPORT
11/22	Spud 11-18-50 8" @ 588' Anhy 908' Drlg. 1080'	
12/20	8" @ 588 Anhy 908 Heeb 3103 Douglas 3133 Cong 3394 5" @ 3408 TD 3414 FU 2000' oil 5 boph 500 A Comp 443 bopd Completed	Top 2867 Toronto 3119 Lans 3166 Arb 3407-14
	COMPLETED	



Sec. **7** (Blk. **17** (Sur. **14W** Map No.

Well No. 2 Farm. Curtis

Elev.	11 7.5'	Location	NW	NW	SE
-------	---------	----------	----	----	----

FIRST REPORT

1st. Report NOV 22 1950

Completion

Remarks	Sunray & Derby Oil
	Derby Drlg. & Contr.

Spudding Date 11-18-50

Drig. Data **Wildcat**


8" @ 588 Anhy 908 drlg 1080

County Barton State Kansas
 Sec. 7 (Blk.) 17 (Sur.) 14W Map No.

Operator Derby Drlg.

Well No. 2 Farm Curtis

Elev. 1918 Location NW NW SE

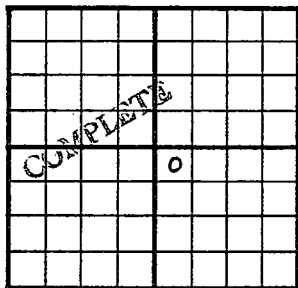

330 Ft. From N Line SE

330 Ft. From W Line Quarter

1st. Report

Completion DEC 20 1950

Remarks Wildcat

Derby Drlg. - Contr.

Spudding Date 11-18-50

Drlg. Data Oil well TD 3414

8" C 588 Anhy 908 Top. 2867

Heeb. 3103 Toronto 3119 Douglas 3133

Lans. 3166 Cong. 3394 Arb. 3407-14

5" C 3408 TD 3414 FU 2000' oil

5 bopd 500 A Comp. 443 bopd

J. E. TYRA