


Barton

Section 7 Township 17 Range 14W **KANSAS**

Well No. #3 Curtis

Company Derby Drlg.

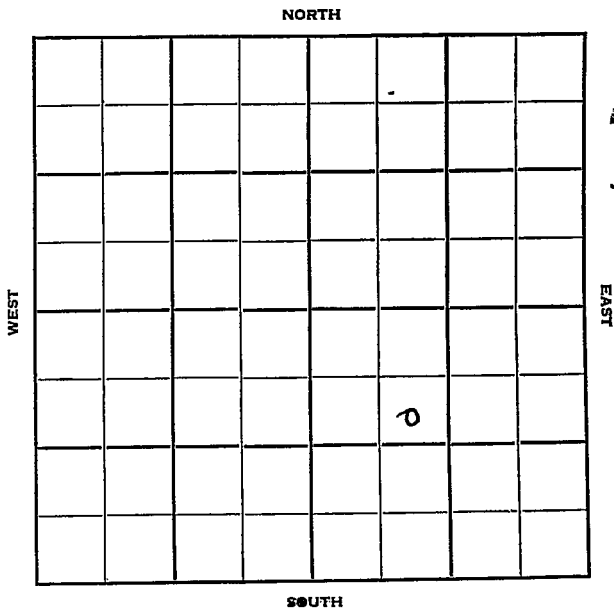

Barton

KANSAS

Sec. 7 Twp. 17 R. 14W

Well No. #3 Curtis Farm

Derby Drlg. Company

Contractor


990' Leoville Pool
Ft. from N. Line

Ft. from S. Line

Ft. from E. Line

990' Ft. from W. Line

SE NW SE

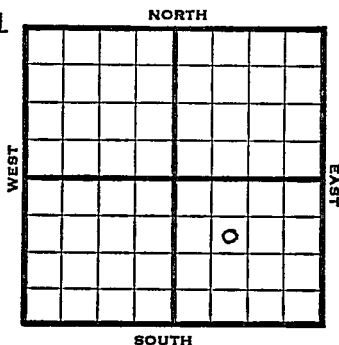

1951

Elev. 1933'

REPORT

1/3

Location

4/4

Spud 1-5-51 Oil well TD @ 3478'
8" @ 575' Anhy 935-65' Top. 2879'
Heeb 3113' Lans. 3177'
DST 3267-74 open 1 hr. Rec. 16' mud
Cong. 3404, Simp. 3428' Arb. 3434'
5" @ 3477' CO to 3445' 12/3433-35
500 A water SP 3275' 24/3267-73
500 A 2000
Comp. 26 BOPD 55% water

COMPLETED


County Barton State Kansas
 Sec. 7 (Blk. 17 (Sur. 14W Map No.
 (Twp. 17 (Rge. 14W)
 Operator Derby Drlg.
 Well No. 3 Farm Curtis
 Elev. _____ Location SE NW SE

FIRST REPORT

990 Ft. From N Line SE
 990 Ft. From W Line Quarter
 Ist. Report JAN 3 1951
 Completion _____
 Remarks _____
 Spudding Date _____

Drlg. Data Leoville Pool
 Location _____

County Barton State Kansas
 Sec. 7 (Blk.) 17 (Sur.) 14W Map No.
 Operator Derby Drlg.
 Well No. 3 Farm Curtis
 Elev. 1933 Location SE NW SE

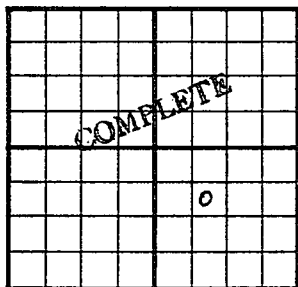

990 Ft. From N Line SE
990 Ft. From W Line Quarter
 Ist. Report
 Completion APR 4 1951
 Remarks Leoville Pool
 Spudding Date 1-5-51

Drlg. Data Oil well TD 3478
8" @ 575 Anhy 935-65 Top. 2879
Heeb. 3113 Lans. 3177 DST 3267-74
open 1 hr. Rec. 16' mud Cong. 3404
Simp. 3428 Arb. 3434 5" @ 3477
CO to 3445 12/ 3433-35 500 A water
SP 3275 24/ 3267-73 500 A 2000
Comp. 26 bopd 55% water