

KANSAS


Barton

FORM 51 5M 10-41 PETROL

Section 1 Township 16 Range 11-W

Well No. #1 McFarland

Company Nate Appleman

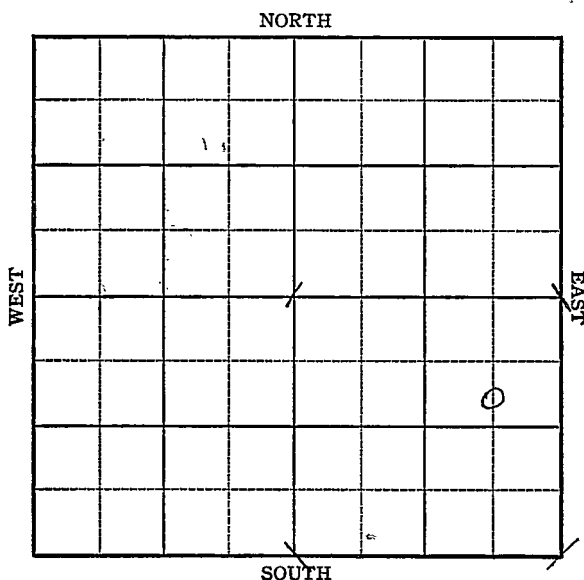


KANSAS

Barton

Sec. 1 Twp. 16 R. 11-WWell No. #1 McFarland FarmNate Appleman Company

Stoltenberg

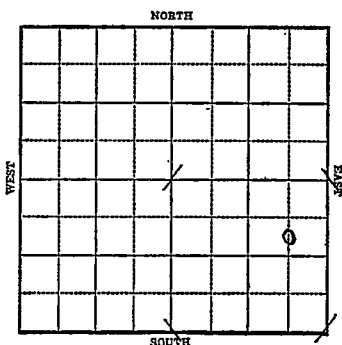990 Ft. from N. Line         Ft. from S. Line660 Ft. from E. Line         Ft. from W. LineC SL NE SE EL. 1851

1943

## R E P O R T

2/17 Location.

2/24 Derrick

3/3 "

3/10 Surface hole

3/16 8" Casing set 350' SD

3/24 Annhy 675  
Drlg. 2175'

3/31 Lans 3013 Drlg. 3080

4/7 Arb 3335  
5" @ 3337  
Water  
T.D. 3364'**ABANDONED**

Barton

Map No. KANSAS Sec. 1 Twp. 16 R. 11WWell No. 1 McFarland

Nate Appleman

Company

## FIRST REPORT

Contractor

C SL NE SE


## SECTION PLAT

990 Ft. from N. Line

Ft. from S. Line

660 Ft. from E. Line

Ft. from W. Line

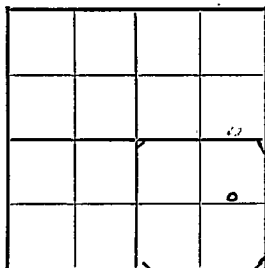

## STOLTENBERG POOL

Location XXX

Rig up

Drilling and Remarks:

## RECORD

Cased \_\_\_\_\_ in., \_\_\_\_\_ ft.

Sand \_\_\_\_\_

Gas \_\_\_\_\_

Oil \_\_\_\_\_

Total Depth \_\_\_\_\_

## PRODUCTION

1st 24 hrs. Nat. \_\_\_\_\_

1st 24 hrs. after shot \_\_\_\_\_

Gas \_\_\_\_\_ Cu. Ft.

Dry Hole \_\_\_\_\_

Abandoned \_\_\_\_\_

Date

FEB 17 1943

19

S. J. LEWIS

Scout

KANSAS

Barton

Map No. 55 Sec. 1 Twp. 16 R. 11WWell No. 1 McFarlandNate Appleman CompanyABANDONED Contractor

C SL NE SE

990 Ft. from N. Line         Ft. from S. Line660 Ft. from E. Line         Ft. from W. Line

## SECTION PLAT

|  |  |  |   |
|--|--|--|---|
|  |  |  |   |
|  |  |  |   |
|  |  |  |   |
|  |  |  | o |
|  |  |  |   |

## STOLTENBERG P OOL

Location                     Rig up                     

Drilling and Remarks:

*Cr 8.3335**5" @ 3337**Water.*

## RECORD

Cased          in.,          ft.Sand                     Gas                     Oil                     Total Depth 3364

## PRODUCTION

1st 24 hrs. Nat.                     1st 24 hrs. after shot                     Gas          Cu. Ft.Dry Hole                     Abandoned                     

Date

APR 7 1943 19

S. J. LEWIS Scout