


Section 18 Township 17 Range 14-WWell No. #3 Koch "A"Company Ben Brack
Axland Pool

NORTH

WEST

EAST

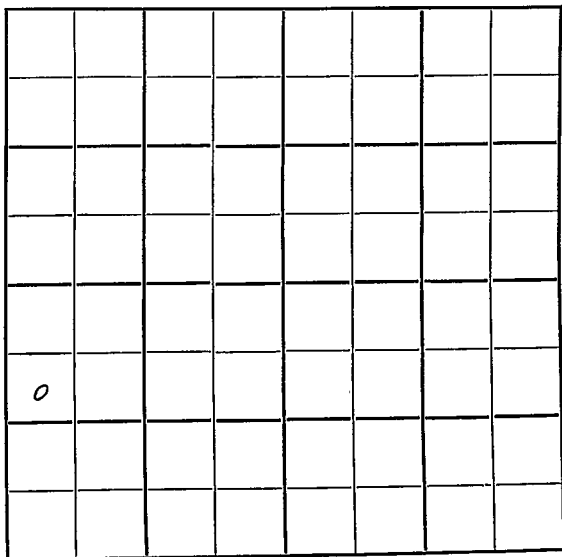

SOUTH

Barton

KANSAS ✓

Sec. 18 Twp. 17 R. 14W

Well No. #3 Koch "A" Farm

Ben Brack Company

Axland Pool Contractor


990' Ft. from N. Line

 Ft. from S. Line

 Ft. from E. Line

330' Ft. from W. Line

SW NW SW

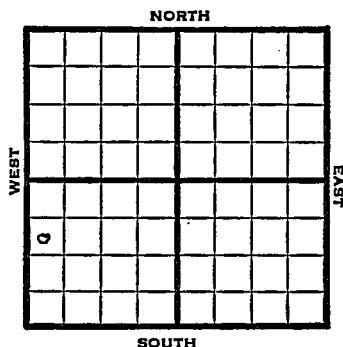

1950

Elev. 1882' REPORT

3/8

Spud 3-4-50

Anhy 892'

8-5/8" @ 909'

4/19

TD 3420'

Anhy 892

8 5/8" @ 909

Lans 3148'

Cong 3369'

Arb. 3404'

5"@ 3405

DST 3405-10

Rec 20' mud

D&A

Aband.

ABANDONED

Map No. _____ Sec. 18 Twp. 17 R. 14WWell No. 3 Koch "A"_____
Ben Brack Company_____
Contractor

SW NW SW

Ft. 1882

SECTION PLAT

990 Ft. from N. Line

FIRST REPORT

O

Ft. from S. Line_____
Ft. from E. Line330 Ft. from W. LineBarton County

Location _____

Rig up _____

Drilling and Remarks:

Spud 3-4-50

Anhy 892

8 5/8" @ 909

RECORD

Cased _____ in., _____ ft.

Sand _____

Gas _____

Oil _____

Total Depth _____

PRODUCTION

1st 24 hrs. Nat. _____

1st 24 hrs. after shot _____

Gas _____ Cu. Ft.

Dry Hole _____

Abandoned _____

Date

MAR 8 1950

19

J. E. TYRA Scout

Kansas

Map No. _____ Sec. 18 Twp. 17 R. 14WWell No. 3 Koch "A"

Ben Brack _____ Company

Contractor

SW NW SW


E. 1. 1882

SECTION PLAT

990 Ft. from N. Line

_____ Ft. from S. Line

_____ Ft. from E. Line

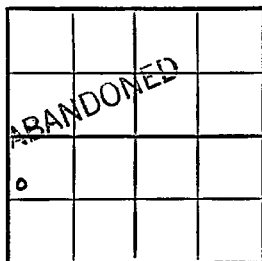550 Ft. from W. Line

Barton County

Location _____

Rig up _____

Drilling and Remarks:

anby. 892*8 7/8' c* 909*Lans.* 3148*Conj.* 3369*arb.* 3404*5" c* 3405*DST.* 3405-710*Rec. 20' mud**Date D+A*

RECORD

Cased _____ in., _____ ft.

Sand _____

Gas _____

Oil _____

Total Depth 3420

PRODUCTION

1st 24 hrs. Nat. _____

1st 24 hrs. after shot _____

Gas _____ Cu. Ft.

Dry Hole _____

Abandoned _____

APR 19 1950

19

J. E. TYRA Scout