

Barton


KANSAS

FORM 51 25M 3-49 PETROL

Section 18 Township 17 Range 14W

Well No. #1 S. Koch

Company Ben Brack

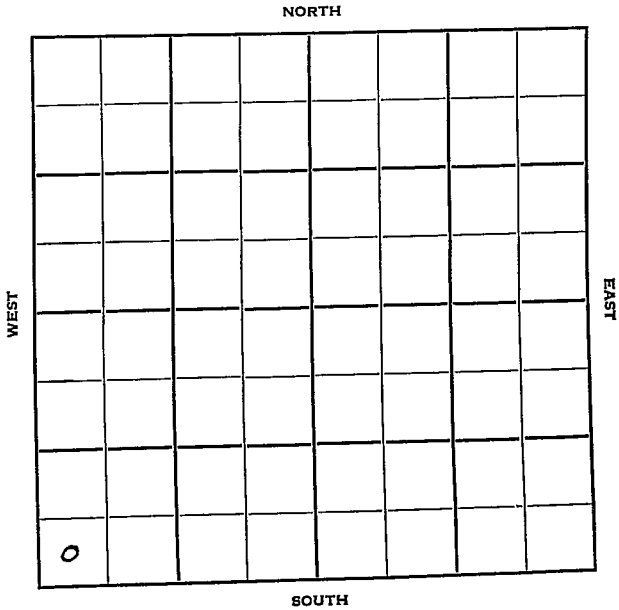

Barton

KANSAS

Sec. 18 Twp. 17 R. 14W

Well No. #1 S. Koch Farm _____

Ben Brack Company
Axman Pool

_____ Ft. from N. Line

330'


_____ Ft. from S. Line

_____ Ft. from E. Line

330'

_____ Ft. from W. Line

SW SW SW

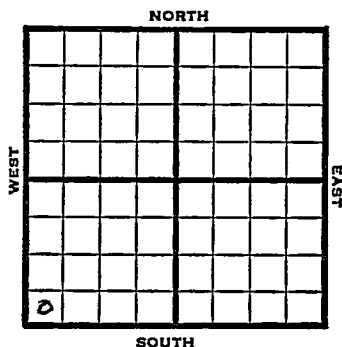

1950

Elev 1899⁰ R E P O R T

1/11

MIM

2/22

TD 3397'

8" @ 921'

5" @ 3392'

Lans 3159'

Arb. 3392'

813 BOPD

Comp

COMPLETED

Kansas

Axman Pool

Map No. _____ Sec. 18 Twp. 17 R. 14WWell No. 1 S. KochBen Brack

Company

Contractor

SW SW SW

SECTION PLAT

_____ Ft. from N. Line

330 Ft. from S. Line

_____ Ft. from E. Line

330 Ft. from W. Line.

Barton County

Location _____

Rig up _____

Drilling and Remarks: _____

M I M

RECORD

Cased _____ in., _____ ft.

Sand _____

Gas _____

Oil _____

Total Depth _____

PRODUCTION

1st 24 hrs. Nat. _____

1st 24 hrs. after shot _____

Gas _____ Cu. Ft.

Dry Hole _____

Abandoned _____

Date


JAN 11 1950 19J. E. TYRA Scout

~~Kansas~~Map No. _____ Sec. 18 Twp. 17 R. 14WWell No. 1 S. Koch_____Ben Brack_____
Company_____
Contractor

SW SW SW

E1. 1899
SECTION PLAT_____Ft. from N. Line330 Ft. from S. Line_____Ft. from E. Line330 Ft. from W. Line

Barton County

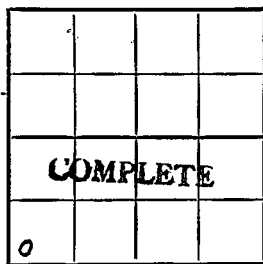

Location _____

Rig up _____

Drilling and Remarks:

8' @ 9215' @ 3392Lanz 3159Ant 3392813 BOPD.d**RECORD**

Cased _____ in., _____ ft.

Sand _____

Gas _____

Oil _____

Total Depth 3397**PRODUCTION**

1st 24 hrs. Nat. _____

1st 24 hrs. after shot _____

Gas _____ Cu. Ft.

Dry Hole _____

Abandoned _____

Date

FEB 22 1950 19J. E. TYRA Scout